

State Well Report

Part 1 - Driller's Log

Mississippi Department of Environmental Quality
 Office of Land and Water Resources
 P.O. Box 10631
 Jackson, MS 39289-0631
 (601)961-5210
 (601)354-6938 (fax)

For Office Use Only:

Aquifer: _____
 Well #: D-138
 L. S. Elevation: _____
 E-log #: _____

County: Choctaw
 Permit #: _____
 Driller: Randy SALERS
 Date drilling completed: 3-27-07

State Law requires that this report be prepared by the license holder responsible for the work and filed with the Department at the above address within 30 days of completion of drilling of the well or borehole.

Information on Well Owner <i>(Landowner if borehole is not for a water well)</i>	Well or Borehole Location
Owner Name: <u>MS Lignite Mining Co.</u>	Latitude: <u>33° 23' 21"</u> Longitude: <u>89° 14' 53"</u>
Mailing Address: <u>1000 McIndree Rd</u> <u>Ackerly, MS 39235</u>	Method of Lat/Long (circle one): Conventional Survey, USGS quad, Hand-held GPS, <u>Survey-grade GPS</u>
City _____ State _____ Zip Code _____	<u>SE</u> ¼ <u>SE</u> ¼ Sec <u>28</u> Twn <u>18N</u> Rng <u>10E</u>
Telephone No. (601) <u>387-5200</u>	Distance _____ Direction _____ Nearest Town _____ <u>2.5</u> Miles <u>NW</u> of <u>CHESTER</u>

Well / Borehole Data

Date drilling started: 3-3-07 Date drilling completed: 3-27-07 Hole depth: 200 Hole diameter: 4 3/4

Location of the source of any surface water used for drilling: LITTLE OXYN CREEK

Method of dosing and volume of Chlorine used in drilling and development: 1 GAL BLEACH TO 500 GAL OF WATER

Logs run (circle all applicable): No log run Electric Gamma Ray Density Sonic Neutron Other: _____

Name of organization running log(s): CENTURY GEOPHYSICAL CORP

Purpose of borehole (check one): Water Well Geotechnical/Geological Investigation _____ Ground Source Heat Pump _____

Seismic Survey _____ Other (describe) _____

If drilling is not related to water well construction, skip the remainder of this block

Purpose of Well (check one): Home Industrial Public Supply Irrigation Fish Culture Other: _____

If a flowing well, method of flow regulation: Valve _____ Other (describe) _____

Static Water Level: 139 feet above or below (circle one) land surface Date measured: 4-23-07

Method of Measurement (circle one) steel tape electric tape air line other: _____

Well depth: 200 Well grouted to a depth of 150 feet Type of grout (circle one): Neat Cement Bentonite Mix

Casing length: 163 feet Casing diameter: 4 inches Type of casing: PVC

Screen length: 40 feet Screen diameter: 4 inches Type of screen: PVC

Screen slot size: 0.01 inches Setting depth: From 155 feet to 195 feet

Type of completion (circle all applicable): Gravel packed Underreamed Telescoped Open hole Natural Development

Other (describe): _____

Top of lap pipe or reduction in casing: _____ feet. *If telescoped or more than one screen, describe on next page*

Form: OLWR-SWR-1A


RECEIVED
 JUN 27 2007
 BY: OLWR

D-138

The sketch below only required for water wells

Description of formations encountered must be provided for all wells and boreholes, unless specifically exempted by regulations


If well telescopes, show depths on sketch.

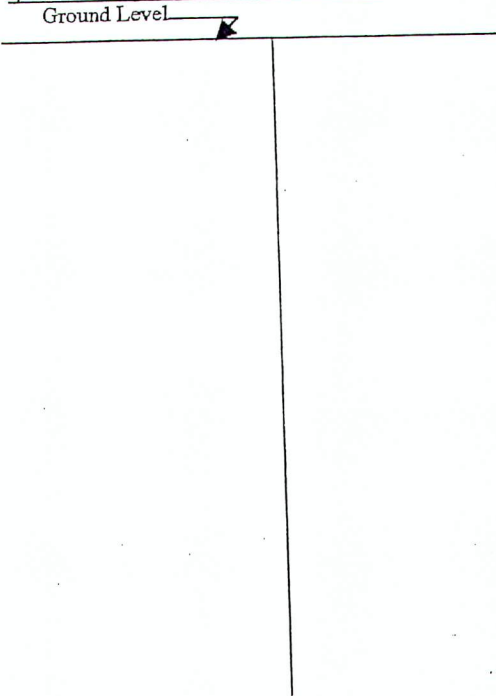

Description of Formations Encountered	From (depth)	To (depth)
SAND	Ground Level	47
LIGNITE	47	51
SAND	51	65
LIGNITE	65	73
CLAY	73	85
LIGNITE	85	92
GLAY SANDY CLAY	92	125
LIGNITE	125	130
SAND, SILT	130	148
LIGNITE	148	154
SAND	154	176
LIGNITE	176	179
SAND	179	190

If more than one screen, show location of each on sketch

Sketch the property layout and include the following: 1) the well location; 2) any permanent structures on the property that may aid in locating the well; 3) any roads, power lines, or other items that may aid in locating the property and the well; 4) a north arrow.

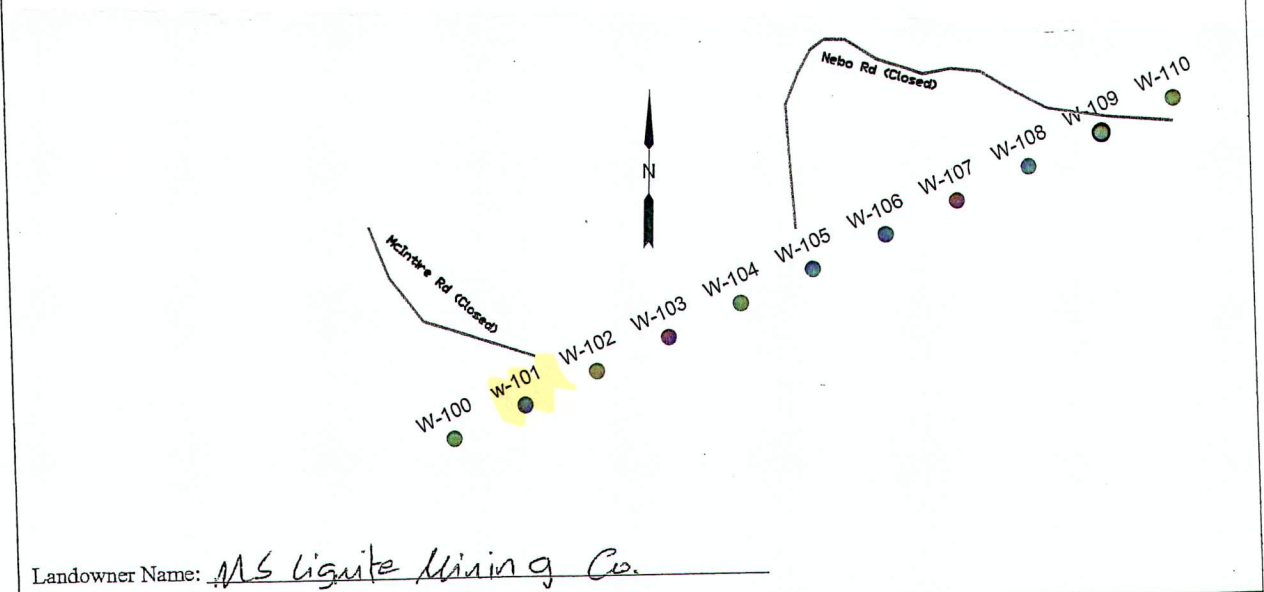

Form: OLWR-SWR-1A

I certify that the well/borehole was drilled, constructed, and completed in accordance with all applicable requirements of the Mississippi Department of Environmental Quality and the Mississippi Department of Health regulations, if applicable, and state laws.

Print Name of Responsible Licensee and License No. Randy SAIBOS MS LC 0779 GM

Date 6-20-07

Signature of Licensee Randy Saibos

RECEIVED
JUN 27 2007
BY: OLWR

STATE WELL REPORT

Part 2

Pump Installer's Completion Report
 Mississippi Department of Environmental Quality
 Office of Land and Water Resources
 P.O. Box 10631
 Jackson, MS 39289-0631
 (601)961-5210
 (601)354-6938 (fax)

County: Choctaw
 Permit #: _____
 Driller: Randy Sakers
 Date completed: 3-27-07
Copy information from block on Part 1

For Office Use Only:

Aquifer: _____
 Well #: D-138
 Elevation: _____

This part of the report must be completed by a licensed water well contractor or a licensed pump installer. A copy of Part 1 of the report must be attached and both parts filed with the Department at the above address within 30 days of well completion.

Well Owner Information	Well Location
Owner Name: <u>MS Lignite Mining Co.</u>	Latitude: <u>33°23'21"</u> Longitude: <u>89°14'53"</u>
Mailing Address: <u>1000 McEntire Rd</u> <u>Akerman, MS 39735</u>	Method of Lat/Long (check one): Conventional Survey _____ USGS quad _____, Hand-held GPS _____, Survey-grade GPS <input checked="" type="checkbox"/>
City State Zip Code	<u>SE 1/4 SE 1/4 Sec 28 T 18N R 10E</u>
Telephone No. <u>(662) 387-5200</u>	Distance Direction Nearest Town <u>2.5 Miles NW of CHESTER</u>

Pump Type Circle one	Power Type Circle one
Air Lift Jet <input type="checkbox"/> <u>Submersible</u>	Diesel Engine Gasoline Engine Natural Gas
Bucket Piston Turbine	<u>Electric Motor</u> Hand Tractor PTO
Centrifugal Rotary Flowing Well	Windmill Other (specify): _____
Other (specify): _____	Horse Power Rating of Motor: <u>5</u>
Date Pump Installed: <u>5-1-07</u>	Setting Depth: <u>180</u> feet
Rated Pump Capacity: <u>7.5</u> Gallons Per Minute	Number of Stages: _____

Pump Test Data	Method of Measuring Water Level Circle one
Date Well Tested: <u>5-1-07</u>	Air Line <input type="checkbox"/> <u>Electric Measuring Line</u> Steel Tape
Static Water Level (A): <u>139</u> Feet Below Land Surface	Other (specify): _____
Pumping Water Level (B): <u>180</u> Feet Below Land Surface	For flowing well, measured shut in head: _____ feet
Drawdown [(B) - (A)]: <u>41</u> Feet Below Land Surface	Well yielded <u>3</u> GPM with a drawdown of
Test Pumping Rate: <u>3</u> Gallons Per Minute	<u>41</u> feet after <u>4</u> hours of pumping
Duration of Pump Test (minimum 4 hours): <u>4</u> hours	

I HEREBY CERTIFY that the above statements are true to the best of my knowledge.

Randy Sakers MS Lic 0779 GA Randy Sakers
 Print Name of Pump Installer and License No. (if applicable) Signature of Pump Installer

RECEIVED
 JUN 27 2007
 BY: OLWR