_	State We	ell Report	
(1 . (riller's Log	For Office Use Only:
County: ChoctAw			Aquifer:
Permit #:	Mississippi Department of Environmental Quality Office of Land and Water Resources		Well#: D-142
Driller: RANDY SALERS	P.O. Box 10631		l i
•	Jackson, MS 39289-0631		L. S. Elevation:
Date drilling completed: 3-30-07		961-5210 1-6938 (fax)	E-log#:
] (001)55-	-0/20 (14A)	
State Law requires that this repo	rt be prepared by the lice	nse holder responsible for	the work and filed with the
Department at the above addres	s within 30 days of comp	letion of arilling of the well	orehole Location
Information on Well	Owner		
(Landowner if borehole is not		Latitude: 33 ° 22 , 52	_" Longitude: 89 ° 13 ' 51 "
Owner Name 195 Lignife Mir	ing Co.	Method of Lat/Long (circle o	nne). Conventional Survey.
Mailing Address: 1000 Mant			
-		-	d GPS, Survey-grade GPS
Ackernan,	M> 39135	SE 14 NE 14 Sec 3'	Twn 18 N Rng 10 €
Only	tate Zip Code	Distance Direction 7.5 Miles Nw	Nearest Town of Classes
Telephone No. (1962) 387 - 5	200		
	Well / Bore	ehole Data	
Date drilling started: 9-23-06 Date drilling completed: 3-30-07 Hole depth: 275' Hole diameter: 434			
Location of the source of any surface w Method of dosing and volume of Chlor			
Logs run (circle all applicable): No log Name of organization running log(s):	run Electric Gamma Ra	Density Sonic Neutron	Other:
Purpose of borehole (check one): Water Well Y Geotechnical/Geological Investigation Ground Source Heat Pump			
Seismic Survey Other (describe) If drilling is not related to water well construction, skip the remainder of this block			
Purpose of Well (check one): Home (
If a flowing well, method of flow regulation: Valve Other (describe)			
Static Water Level: 181feet above or below (circle one) land surface Date measured: 4-15-07			
Method of Measurement (circle one) steel tape electric tape air line other:			
Well depth: 275 Well grouted to a depth of 225 feet Type of grout (circle one): Neat Cement Bentonite Mix			
Casing length: 738 feet Casing diameter: 4 inches Type of casing: PVC Screen length: 40 feet Screen diameter: 4 inches Type of screen: PVC			
Screen length: 40 feet	Screen diameter: 4	inches Type of screen	270
Screen slot size: O.O/ inches Setting depth: From 230 feet to 270 feet			
Type of completion (circle all applica		_	Open hole Natural Development
	•		
Top of lap pipe or reduction in casing	:	felescoped or more than one	
			EOUTH OLIMP SIMP 1

FORECEIVED


JUN 27 2007

BY: OLWR

If well telescopes, show depths on sketch. Ground Level.			

Description of Formations Encountered		o (depth)
Sand	Ground Level	14
(12,	16	85
limite	8-5	86
00/-	860	100
Clay L'inite L'inite	100	102
	102	144
elay L'Inite	144	149
610174	149	154
Clay Lignite	149	156
Light	156	180
Clay.	180	182
19 Ligar T4	182	225
- Clar	225	229
Lignite sand	729	250
sand	229	253
L. Snite	253	260
Sacol		
	 	
		-

If more than one screen, show location of each on sketch

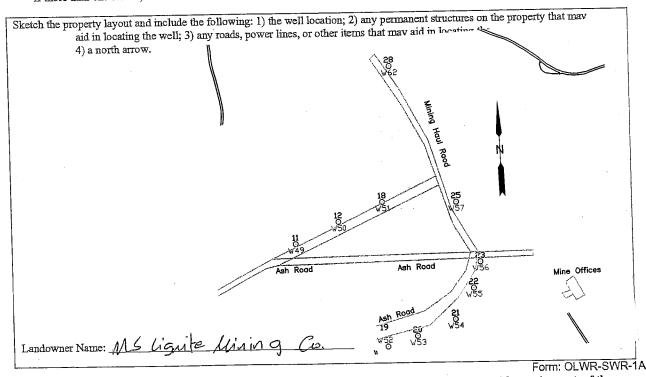

I certify that the well/borehole was drilled, constructed, and completed in accordance with all applicable requirements of the Mississippi Department of Environmental Quality and the Mississippi Department of Health regulations, if applicable, and state

KALLY SALEYS MS Lic 0779 6-15-07

RECEIVED

Print Name of Responsible Licensee and License No.

Signature of Licensee

JUN 27 2007

BY: OLWR

STATE WELL REPORT

Part 2

Pump Installer's Completion Report Mississippi Department of Environmental Quality

Office of Land and Water Resources P.O. Box 10631 Jackson, MS 39289-0631 (601)961-5210 (601)354-6938 (fax)

For Office Use Only:		
Aquifer:		
Well#: D- /42		
Elevation:		

Copy information from block on Part 1

County CTOCTAN

Driller: AND

Date completed:

This part of the report must be completed by a licensed water well contractor or a licensed pump installer. A copy of Part 1 of the report must be attached and both parts filed with the Department at the above address within 30 days of well completion.

Well Owner Information	Well Location	
Owner Name: MS Lignite Mining Co.	Latitude: 33°72′52″ Longitude: 89°13′51″	
Mailing Address: 1000 MEntire Rd	Method of Lat/Long (check one): Conventional Survey,	
Ackerman ms 39735	USGS quad, Hand-held GPS, Survey-grade GPS_	
	SE 1/4 NE 1/4 Sec 34 T 18N R 10E	
City State Zip Code	Distance Direction Nearest Town	
Telephone No. (462) 387-5200	2.5 Miles NW of CHESTER	

	Pump Type Circle one		-	Power Type Circle one	
Air Lift	Jet	Submersible	Diesel Engine	Gasoline Engine	Natural Gas
Bucket	Piston	Turbine	Electric Motor	Hand	Tractor PTO
Centrifugal	Rotary	Flowing Well	Windmill	Other (specify):	
Other (specify):			Horse Power Rating	of Motor:	
Date Pump Installed:	4-27-07	<u> </u>	Setting Depth:	216	feet
Rated Pump Capacity:	7.5	Gallons Per Minute	Number of Stages:	W (* L+ + 1	20 pg

Pump Test Data 4-27-07 Static Water Level (A):/ Feet Below Land Surface Pumping Water Level (B):/ Feet Below Land Surface Drawdown [(B) - (A)]:/ Feet Below Land Surface Test Pumping Rate: Gallons Per Minute Duration of Pump Test (minimum 4 hours):/ hours	Method of Measuring Water Level Circle one Air Line Electric Measuring Line Steel Tape Other (specify): For flowing well, measured shut in head: GPM with a drawdown of feet after hours of pumping
--	--

I HEREBY CERTIFY that the above statements are true to the best	of my knowledge.
RANDY SAVEYS MS LIK 0779 GM	Randy Solem BECFIVED
Print Name of Pump Installer and License No. (if applicable)	Signature of Pump Installer
Finit Name of Fump instance and Dicense (12 deprices)	Form OhMPLSWR-1R

BY: OLWR