

DW 52

State Well Report

Part 1 - Driller's Log

Mississippi Department of Environmental Quality
Office of Land and Water Resources
P.O. Box 10631
Jackson, MS 39289-0631
(601)961-5210
(601)354-6938 (fax)

For Office Use Only:

Aquifer: _____
Well #: D-162
L. S. Elevation: _____
E-log #: _____

County: CTOSIAN
Permit #: _____
Driller: RANDY SAVERS
Date drilling completed: 4-30-07

State Law requires that this report be prepared by the license holder responsible for the work and filed with the Department at the above address within 30 days of completion of drilling of the well or borehole.

Information on Well Owner <i>(Landowner if borehole is not for a water well)</i>	Well or Borehole Location
Owner Name: <u>MSignite Mining Co.</u>	Latitude: <u>33° 22' 48.73"</u> Longitude: <u>89° 14' 03"</u>
Mailing Address: <u>1000 McAndrew Rd</u>	Method of Lat/Long (circle one): Conventional Survey,
<u>Ackerman, MS 39735</u>	USGS quad, Hand-held GPS, <u>Survey-grade GPS</u>
City State Zip Code	<u>SW 1/4 NE 1/4 Sec 34 Twn 18N Rng 10E</u>
Telephone No. <u>(662) 387-5200</u>	Distance Direction Nearest Town <u>2.5</u> Miles <u>NW</u> of <u>CHESTER</u>

Well / Borehole Data

Date drilling started: 7-24-06 Date drilling completed: 4-30-07 Hole depth: 300' Hole diameter: 4 3/4"

Location of the source of any surface water used for drilling: LITTLE BIVY CREEK

Method of dosing and volume of Chlorine used in drilling and development: 1 GAL BLEACH TO 500 GAL OF WATER

Logs run (circle all applicable): No log run Electric Gamma Ray Density Sonic Neutron Other: _____

Name of organization running log(s): CENTURY LEO PHYSICAL CORP.

Purpose of borehole (check one): Water Well Geotechnical/Geological Investigation _____ Ground Source Heat Pump _____

Seismic Survey _____ Other (describe) _____

If drilling is not related to water well construction, skip the remainder of this block

Purpose of Well (check one): Home Industrial Public Supply Irrigation Fish Culture Other: _____

If a flowing well, method of flow regulation: Valve _____ Other (describe) _____

Static Water Level: 210 feet above or below (circle one) land surface Date measured: 5-23-07

Method of Measurement (circle one) steel tape electric tape air line other: _____

Well depth: 300 Well grouted to a depth of 250 feet Type of grout (circle one) Neat Cement Bentonite Mix

Casing length: 258 feet Casing diameter: 4 inches Type of casing: PVC

Screen length: 40 feet Screen diameter: 4 inches Type of screen: PVC

Screen slot size: .01 inches Setting depth: From 255 feet to 295 feet

Type of completion (circle all applicable): Gravel packed Underreamed Telescoped Open hole Natural Development

Other (describe): _____

Top of lap pipe or reduction in casing: _____ feet. *If telescoped or more than one screen, describe on next page*

Form: OLWR-SWR-1A

RECEIVED
JUN 27 2007
BY: OLWR

D-162

The sketch below only required for water wells

Description of formations encountered must be provided for all wells and boreholes, unless specifically exempted by regulations

If well telescopes, show depths on sketch.


Ground Level

Large empty rectangular box for sketching well location and property layout.

Description of Formations Encountered	From (depth) To (depth)	
	Ground Level	
SAND	0	94
LIGNITE	94	98
CLAY	98	115
SAND	116	123
LIGNITE	123	125
SANDY CLAY	125	140
LIGNITE	140	143
CLAY	143	168
LIGNITE	168	174
CLAY	174	176
LIGNITE	176	181
SAND	181	200
LIGNITE	201	204
SAND	205	249
LIGNITE	250	256
SAND	257	300

If more than one screen, show location of each on sketch

Sketch the property layout and include the following: 1) the well location; 2) any permanent structures on the property that may aid in locating the well; 3) any roads, power lines, or other items that may aid in locating the property and the well; 4) a north arrow.

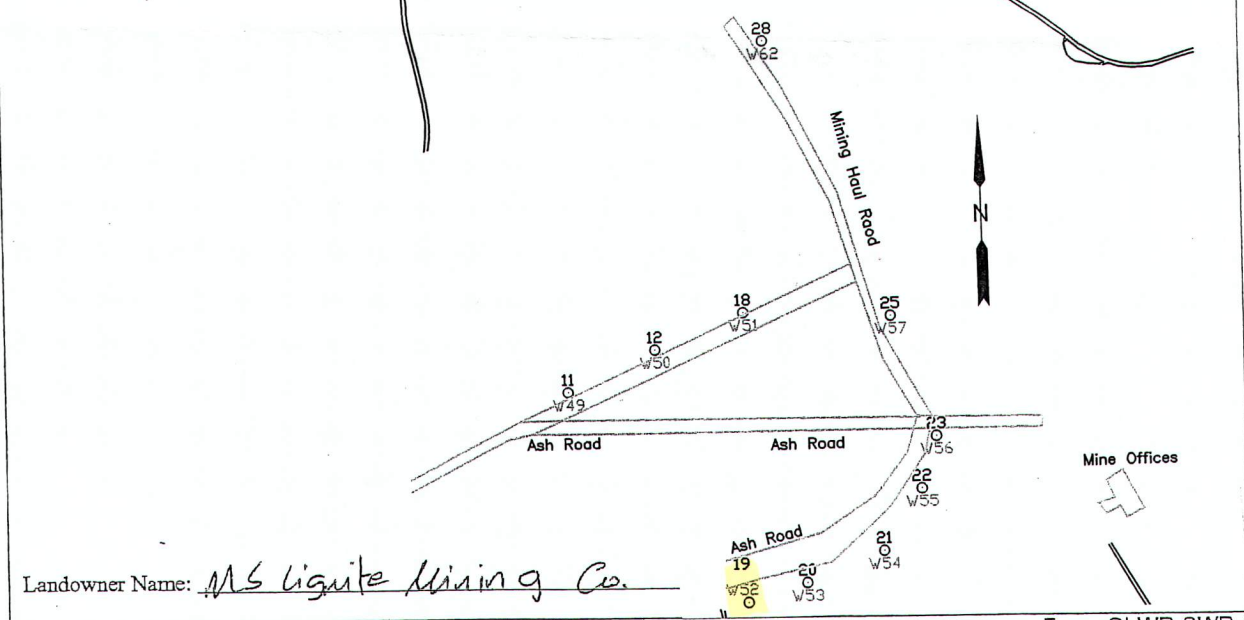

Form: OLWR-SWR-1A

I certify that the well/borehole was drilled, constructed, and completed in accordance with all applicable requirements of the Mississippi Department of Environmental Quality and the Mississippi Department of Health regulations, if applicable, and state laws.

Print Name of Responsible Licensee and License No. Randy SAVERS MSLE 0779 GM

Date 6-15-07

Signature of Licensee Randy Saver

RECEIVED JUN 27 2007 BY: OLWR

STATE WELL REPORT

Part 2

Pump Installer's Completion Report
 Mississippi Department of Environmental Quality
 Office of Land and Water Resources
 P.O. Box 10631
 Jackson, MS 39289-0631
 (601)961-5210
 (601)354-6938 (fax)

County: CHOCTAW
 Permit #: _____
 Driller: RANDY SAJERS
 Date completed: 4-30-07
Copy information from block on Part 1

For Office Use Only:

Aquifer: _____
 Well #: D-162
 Elevation: _____

This part of the report must be completed by a licensed water well contractor or a licensed pump installer. A copy of Part 1 of the report must be attached and both parts filed with the Department at the above address within 30 days of well completion.

Well Owner Information	Well Location
Owner Name: <u>MS Lignite Mining Co.</u>	Latitude: <u>33°22'48"</u> Longitude: <u>89°14'03"</u>
Mailing Address: <u>1000 McZabie Rd</u> <u>Akerman, MS 39735</u>	Method of Lat/Long (check one): Conventional Survey _____ USGS quad _____ Hand-held GPS _____ <u>Survey-grade GPS</u>
City _____ State _____ Zip Code _____	<u>SW 1/4 NE 1/4 Sec 34 T18N R10E</u>
Telephone No. <u>(662) 387-5200</u>	Distance _____ Direction _____ Nearest Town _____ <u>2.5 Miles NW of CHESTER</u>

Pump Type Circle one	Power Type Circle one
Air Lift Jet <u>Submersible</u>	Diesel Engine Gasoline Engine Natural Gas
Bucket Piston Turbine	<u>Electric Motor</u> Hand Tractor PTO
Centrifugal Rotary Flowing Well	Windmill Other (specify): _____
Other (specify): _____	Horse Power Rating of Motor: <u>.5</u>
Date Pump Installed: <u>5-25-07</u>	Setting Depth: <u>294</u> feet
Rated Pump Capacity: <u>7.5</u> Gallons Per Minute	Number of Stages: _____

Pump Test Data	Method of Measuring Water Level Circle one
Date Well Tested: <u>5-25-07</u>	Air Line <u>Electric Measuring Line</u> Steel Tape
Static Water Level (A): <u>210</u> Feet Below Land Surface	Other (specify): _____
Pumping Water Level (B): <u>294</u> Feet Below Land Surface	For flowing well, measured shut in head: _____ feet
Drawdown [(B) - (A)]: <u>84</u> Feet Below Land Surface	Well yielded <u>3</u> GPM with a drawdown of
Test Pumping Rate: <u>3</u> Gallons Per Minute	<u>84</u> feet after <u>4</u> hours of pumping
Duration of Pump Test (minimum 4 hours): <u>4</u> hours	

I HEREBY CERTIFY that the above statements are true to the best of my knowledge.

Randy SAJERS MS LC 0778 GM Randy Sajers
 Print Name of Pump Installer and License No. (if applicable) Signature of Pump Installer

RECEIVED
 Form: OLWR-SWR-1B
JUN 27 2007
BY: OLWR