

State Well Report

Part 1 - Driller's Log

Mississippi Department of Environmental Quality
 Office of Land and Water Resources
 P.O. Box ~~40631~~ **2804**
 Jackson, MS ~~39289-0631~~ **39225**
 (601)961-5210
 (601)354-6938 (fax)

County: Choctaw
 Permit #: _____
 Driller: Randy Siders
 Date drilling completed: 3-19-08

For Office Use Only:
 Aquifer: _____
 Well #: D-171
 L. S. Elevation: _____
 E-log #: _____

State Law requires that this report be prepared by the license holder responsible for the work and filed with the Department at the above address within 30 days of completion of drilling of the well or borehole.

Information on Well Owner <i>(Landowner if borehole is not for a water well)</i>	Well or Borehole Location
Owner Name: <u>Mississippi Lignite Mining Co</u>	Latitude: <u>33° 23' 24.38"</u> Longitude: <u>89° 15' 11.56"</u>
Mailing Address: <u>1000 McIntire Rd</u>	Method of Lat/Long (circle one): <u>24</u> Conventional Survey, <u>12</u>
<u>Ackerman</u> <u>Ms</u> <u>39735</u>	USGS quad, Hand-held GPS, Survey-grade GPS
City State Zip Code	<u>SW 1/4 SE 1/4 Sec 28 Twn 18N Rng 10E</u>
Telephone No. <u>(662) 387 5200</u>	Distance Direction Nearest Town
	<u>2.5</u> Miles <u>NW</u> of <u>Chester</u>

Well / Borehole Data

Date drilling started: 1-17-08 Date drilling completed: 3-19-08 Hole depth: 200 Hole diameter: 4

Location of the source of any surface water used for drilling: Little Bayou Creek

Method of dosing and volume of Chlorine used in drilling and development: 1991 chlorox to SW 1/4 water

Logs run (circle all applicable): No log run Electric Gamma Ray Density Sonic Neutron Other: _____

Name of organization running log(s): Century Geophysical Corp

Purpose of borehole (check one): Water Well Geotechnical/Geological Investigation Ground Source Heat Pump

Seismic Survey Other (describe) _____

If drilling is not related to water well construction, skip the remainder of this block

Purpose of Well (check one): Home Industrial Public Supply Irrigation Fish Culture Other: _____

If a flowing well, method of flow regulation: Valve _____ Other (describe) _____

Static Water Level: 151.5 feet above or below (circle one) land surface Date measured: 3-20-08

Method of Measurement (circle one) steel tape electric tape air line other: _____

Well depth: 198 Well grouted to a depth of 140 feet Type of grout (circle one): Neat Cement Bentonite Mix

Casing length: 158 feet Casing diameter: 4 inches Type of casing: PVC

Screen length: 40 feet Screen diameter: 4 inches Type of screen: PVC

Screen slot size: 0.01 inches Setting depth: From 150 feet to 190 feet

Type of completion (circle all applicable): Gravel packed Underreamed Telescoped Open hole Natural Development

Other (describe): _____

Top of lap pipe or reduction in casing: _____ feet. *If telescoped or more than one screen, describe on next page*

Form: OLWR-SWR-1A

RECEIVED
 APR 14 2008
 BY: OLWR

The sketch below only required for water wells

Description of formations encountered must be provided for all wells and boreholes, unless specifically exempted by regulations

If well telescopes, show depths on sketch.


Ground Level

Ground Level \rightarrow

Description of Formations Encountered	From (depth)	To (depth)
	Ground Level	46
sand	46	52
coal	52	64
sand	64	69
coal	69	99
sand clay	99	106
coal	106	120
sand	120	127
coal	127	146
sand clay	146	154
coal	154	170
sand	170	179
coal	179	200
sand		

If more than one screen, show location of each on sketch

Sketch the property layout and include the following: 1) the well location; 2) any permanent structures on the property that may aid in locating the well; 3) any roads, power lines, or other items that may aid in locating the property and the well; 4) a north arrow.

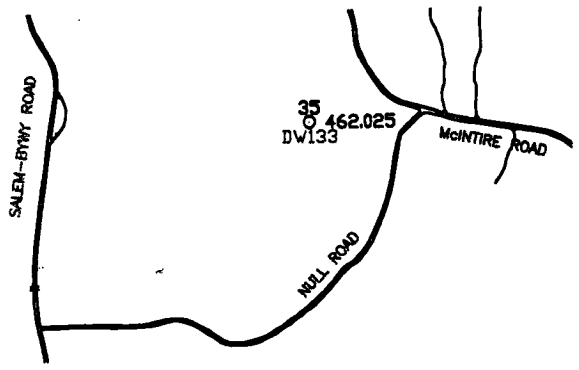

Landowner Name: MS Lignite Mining Co.

Form: OLWR-SWR-1A

I certify that the well/borehole was drilled, constructed, and completed in accordance with all applicable requirements of the Mississippi Department of Environmental Quality and the Mississippi Department of Health regulations, if applicable, and state laws.

Print Name of Responsible Licensee and License No. Randy SALENS MS LIC 07796-01

Date

Randy Salens
Signature of Licensee

Signature of Licensee

RECEIVED
APR 14 2008
BY OLWR

DW133

STATE WELL REPORT

Part 2

Pump Installer's Completion Report
Mississippi Department of Environmental Quality
Office of Land and Water Resources
P.O. Box 10631
Jackson, MS 39289-0631
(601)961-5210
(601)354-6938 (fax)

County: Choctaw
 Permit #: _____
 Driller: Randy Sales
 Date completed: 3-19-08
 Copy information from block on Part 1

For Office Use Only:
 Aquifer: _____
 Well #: D-171
 Elevation: _____

This part of the report must be completed by a licensed water well contractor or a licensed pump installer. A copy of Part 1 of the report must be attached and both parts filed with the Department at the above address within 30 days of well completion.

Well Owner Information	Well Location
Owner Name: <u>MS Lignite Mining Co.</u>	Latitude: <u>33°23'24.38"</u> Longitude: <u>89°15'11.56"</u>
Mailing Address: <u>1000 McEntire Rd</u> <u>Ackerman, MS 39735</u>	Method of Lat/Long (check one): Conventional Survey _____, USGS quad _____, Hand-held GPS _____, Survey-grade GPS <input checked="" type="checkbox"/>
<u>Ackerman MS 39735</u> City State Zip Code	<u>SW ¼ SE ¼ Sec 28 T 18 R 10E</u>
Telephone No. <u>(662) 387-5200</u>	Distance Direction Nearest Town <u>2.5 Miles NW of Chester</u>

Pump Type Circle one	Power Type Circle one
Air Lift Jet <input type="radio"/> <u>Submersible</u>	Diesel Engine Gasoline Engine Natural Gas
Bucket Piston <input type="radio"/> Turbine	<u>Electric Motor</u> Hand Tractor PTO
Centrifugal Rotary <input type="radio"/> <u>Flowing Well</u>	Windmill Other (specify): _____
Other (specify): _____	Horse Power Rating of Motor: <u>.5</u>
Date Pump Installed: <u>3-16-08</u>	Setting Depth: <u>183</u> feet
Rated Pump Capacity: <u>7.5</u> Gallons Per Minute	Number of Stages: _____

Pump Test Data	Method of Measuring Water Level Circle one
Date Well Tested: <u>3-16-08</u>	Air Line <input type="radio"/> <u>Electric Measuring Line</u> Steel Tape
Static Water Level (A): <u>151.5</u> Feet Below Land Surface	Other (specify): _____
Pumping Water Level (B): <u>183</u> Feet Below Land Surface	For flowing well, measured shut in head: _____ feet
Drawdown [(B) - (A)]: <u>32.5</u> Feet Below Land Surface	Well yielded <u>3</u> GPM with a drawdown of
Test Pumping Rate: <u>3</u> Gallons Per Minute	<u>32.5</u> feet after <u>4hr</u> hours of pumping
Duration of Pump Test (minimum 4 hours): <u>4</u> hours	

I HEREBY CERTIFY that the above statements are true to the best of my knowledge.

Randy SAJERS MS 2/C 0779 GM Randy Sales
 Print Name of Pump Installer and License No. (if applicable) Signature of Pump Installer

Form: OLWR-SWR-1B

RECEIVED
APR 14 2008
BY: OLWR