فالمس وسمالكم


	State Well Report	For Office Use Only:
County: Churt	Part 1 – Driller's Log	For Office Use Only:
	Mississippi Department of Environmental Quality	Aquifer:
Permit #:	Office of Land and Water Resources P.O. Box 10631	Well #: <u>D-17</u>
Driller: Rend 5.100	Jackson, MS 39289-0631	L. S. Elevation:
Date drilling completed: $3.26-03$	(601)961-5210	
	(601)354-6938 (fax)	E-log #:
State Law requires that this repo	rt be prepared by the license holder responsible for	the work and filed with th
Department at the above addres	s within 30 days of completion of drilling of the well	l or borehole orehole Location
Information on Well (Landowner if borehole is not j	for a water well	
	Latitude: 35 ° 23 1/ 6	2" Longitude: <u>59° 75' '</u> 3
Owner Name Mississippi Lig	Method of Lat/Long (circle o	ne): Conventional Survey.
Mailing Address: 1000 Mc Int.	at Rd	
	USGS quad, Hand-held	1 GPS, Survey-grade GPS
	NW 1/4 Minth Sec 31	Twn / SN Rng /0
Ackerny M City St	1 SYJ35	•
City St	ate Zip Code Distance Direction	of $Ch \sim T C v$
Telephone No. (662) 387- 521	20	
· · · · · · · · · · · · · · · · · · ·	Well / Borehole Data	· · · · · · · · · · · · · · · · · · ·
	trilling completed: 32607 Hole depth: 138 ter used for drilling: $4747e$ $Brwy Cree$	
Location of the source of any surface wa Method of dosing and volume of Chlori Logs run (circle all applicable): No log r Name of organization running log(s):	ter used for drilling: $\underline{L_1 + 1/e} \underline{B_r w g} \underline{Cre}$ ne used in drilling and development: $\underline{I_{GG} + \underline{CI} + \underline{Cre}}$ un Electric Gamma Ray) Density Sonic Neutron $\underline{Certwy} \underline{Certy} \underline{Certwy} \underline{Certwy} \underline{Certwy} \underline{Cre}$	e K p fr: 500 951 m Other:
Location of the source of any surface wa Method of dosing and volume of Chlori Logs run (circle all applicable): No log r Name of organization running log(s): Purpose of borehole (check one): Water V Seismic	ter used for drilling: $\underline{L_1 + 1/e} \underline{B_r w g} \underline{Cre}$ ne used in drilling and development: $\underline{I_{4,6} + \underline{Clore}}$ un Electric Gamma Ray) Density Sonic Neutron $\underline{Certwg} \underline{CsephySiL_6 + \underline{Co.g}}$ Well \underline{L} Geotechnical/Geological Investigation Groun Survey Other (describe)	e K <u> <u> </u> Other: d Source Heat Pump</u>
Location of the source of any surface wa Method of dosing and volume of Chlori Logs run (circle all applicable): No log r Name of organization running log(s): Purpose of borehole (check one): Water V Seismic	ter used for drilling: $\underline{L_1 + 1/e} \underline{B_r w g} \underline{Cre}$ ne used in drilling and development: $\underline{I_{GG} + \underline{CI} + \underline{Cre}}$ un Electric Gamma Ray) Density Sonic Neutron $\underline{Certwy} \underline{Certy} \underline{Certwy} \underline{Certwy} \underline{Certwy} \underline{Cre}$	e K <u> <u> </u> <u> <u> </u> <u> </u> <u> </u> <u> </u> <u> </u> Other: d Source Heat Pump</u></u>
Location of the source of any surface wa Method of dosing and volume of Chlori Logs run (circle all applicable): No log r Name of organization running log(s): Purpose of borehole (check one): Water V Seismic <u>If drilling is not relate</u> Purpose of Well (check one): Home	ter used for drilling: $_$ <u>Li</u> <u>t</u> <u>t</u> <u>t</u> <u>i</u> <u>e</u> <u>B</u> <u>w</u> <u>y</u> <u>C</u> <u>r</u> <u>e</u> ne used in drilling and development: <u>I</u> <u>4</u> <u>4</u> <u>1</u> <u>4</u>	e K <u> <u> <u> </u> <u> </u></u></u>
Location of the source of any surface wa Method of dosing and volume of Chlori Logs run (circle all applicable): No log r Name of organization running log(s): Purpose of borehole (check one): Water V Seismic <u>If drilling is not relate</u> Purpose of Well (check one): Home If a flowing well, method of flow regulat	ter used for drilling: $\underline{L_i + f + f \in B_{rwg}}$ \underline{Cre} ne used in drilling and development: $\underline{I_{GG} + \underline{CIG}}$ un Electric Gamma Ray) Density Sonic Neutron $\underline{Cre} + \underline{Cre}$ Sonic Neutron $\underline{Cre} + \underline{Cre} + \underline{Cre}$ Sonic Neutron $\underline{Cre} + \underline{Cre} + \underline$	<u>e K</u> <u>r fv: SUU 351 m</u> Other: d Source Heat Pump <u>lock</u> <u>c</u> Other:
Location of the source of any surface wa Method of dosing and volume of Chlori Logs run (circle all applicable): No log r Name of organization running log(s): Purpose of borehole (check one): Water V Seismic <u>If drilling is not relate</u> Purpose of Well (check one): Home If a flowing well, method of flow regulat Static Water Level: 225 feet a	ter used for drilling: $\underline{L_1 + 1 + 2}_{A + a + a + a + a + a + a + a + a + a + $	$\frac{e K}{r + v + 5 + 0 + 3 + 1 + w}$ Other: d Source Heat Pump $lock$ $eOther: 3 - 2 + 5 + 0 + 1 + w$
Location of the source of any surface wa Method of dosing and volume of Chlori Logs run (circle all applicable): No log r Name of organization running log(s): Purpose of borehole (check one): Water V Seismic If drilling is not relate Purpose of Well (check one): Home If a flowing well, method of flow regulat Static Water Level: 22 j feet a Method of Measurement (circle one)	ter used for drilling: $\underline{L_1 + 1 e_B + w + Cree}$ ne used in drilling and development: $\underline{144} + \underline{164} + $	$\frac{e K}{r + v + S UU + s + w}$ Other: d Source Heat Pump $lock$ $\frac{e K}{s - Other:}}$ $\frac{3 - 2 5 - U'}{s - U'}$
Location of the source of any surface wa Method of dosing and volume of Chlori Logs run (circle all applicable): No log r Name of organization running log(s): Purpose of borehole (check one): Water V Seismic If drilling is not related Purpose of Well (check one): Home If a flowing well, method of flow regulat Static Water Level: $I Q Q y$ feet a Method of Measurement (circle one) Well depth: $I Q y$ Well grouted to a c	ter used for drilling: $\underline{L_1 + 1 - B_{FWM}} + Cree$ ne used in drilling and development: $\underline{I_{GG}} + C_{IG-}$ un Electric Gamma Ray) Density Sonic Neutron $\underline{C_{FW}} + C_{FW} + C_{IG} + C_{IG}$ Well \underline{C} Geotechnical/Geological Investigation Groun $\underline{C_{FW}} + C_{IG} + C_{IG}$ Well \underline{C} Geotechnical/Geological Investigation Groun $\underline{C_{FW}} + C_{IG} + C_{IG}$ Well \underline{C} Geotechnical/Geological Investigation Groun $\underline{C_{FW}} + C_{IG} + C_{IG}$ $\underline{C_{FW}} + C_{IG} + C_{IG}$ Well \underline{C} Geotechnical/Geological Investigation Groun $\underline{C_{FW}} + C_{IG} + C_{IG}$ $\underline{C_{FW}} + C_{IG} + C_{IG} + C_{IG}$ $\underline{C_{FW}} + C_{IG} + C_{IG} + C_{IG} + C_{IG}$ $\underline{C_{FW}} + C_{IG} +$	$\frac{e K}{e + v + S UU + s + w}$ Other: d Source Heat Pump $\frac{lock}{e - Other:}$ $\frac{3 - 2 5 - U'}{2 - U'}$ ment Bentonite Mix
Location of the source of any surface wa Method of dosing and volume of Chlori Logs run (circle all applicable): No log r Name of organization running log(s): Purpose of borehole (check one): Water V Seismic If drilling is not related Purpose of Well (check one): Home If a flowing well, method of flow regulat Static Water Level: 223 feet a Method of Measurement (circle one) Well depth: $(23)^{-}_{-}$ Well grouted to a co Casing length: $(23)^{-}_{-}$ feet Cas	ter used for drilling: $___$ $+_$ $+_$ $+_$ $+_$ $+_$ $+_$ $+_$	$\frac{e K}{e + iv SUU 351 m}$ Other: d Source Heat Pump $\frac{lock}{e = 0 \text{ ther: } }$ $\frac{3 - 26 - 0}{2}$ ment Bentonite Mix PVC
Location of the source of any surface wa Method of dosing and volume of Chlori Logs run (circle all applicable): No log r Name of organization running log(s): Purpose of borehole (check one): Water V Seismic If drilling is not related Purpose of Well (check one): Home If a flowing well, method of flow regulat Static Water Level: 22.5 feet a Method of Measurement (circle one) Well depth: $(83)^2$ Well grouted to a c Casing length: feet Case Screen length: feet Scr	ter used for drilling: $__$ $_$ $_$ $_$ $_$ $_$ $_$ $_$ $_$ $_$	$\frac{e K}{r + v + 5 + 0 + 3 + 1 + w}$ Other:
Location of the source of any surface wa Method of dosing and volume of Chlori Logs run (circle all applicable): No log r Name of organization running log(s): Purpose of borehole (check one): Water V Seismic If drilling is not relate Purpose of Well (check one): Home If a flowing well, method of flow regulat Static Water Level: $J \not 2 \not 2 \not y$ feet a Method of Measurement (circle one) Well depth: $I \not 3 \not 3$ Well grouted to a of Casing length: feet Casing length: feet Screen length: feet Screen slot size: $O \cup I$ inches	ter used for drilling: $___$ $+_$ $+_$ $+_$ $+_$ $+_$ $+_$ $+_$	$\frac{e K}{r + v + 5 + 0 + 3 + 1 + w}$ Other:
Location of the source of any surface wa Method of dosing and volume of Chlori Logs run (circle all applicable): No log r Name of organization running log(s): Purpose of borehole (check one): Water V Seismic If drilling is not relate Purpose of Well (check one): Home If a flowing well, method of flow regulat Static Water Level: $I \not I \not Z \not y$ feet a Method of Measurement (circle one) Well depth: $I \not I \not I$ feet Cas Screen length: $I \not I \not I$ feet Scr Screen slot size: $O \cup I$ inches	ter used for drilling: $___$ $__$ $__$ $__$ $__$ $__$ $__$ $_$	$\frac{e K}{e + v + 5 + 0 + c + c + 1}$ Other:
Location of the source of any surface wa Method of dosing and volume of Chlori Logs run (circle all applicable): No log r Name of organization running log(s): Purpose of borehole (check one): Water V Seismic If drilling is not relate Purpose of Well (check one): Home If a flowing well, method of flow regulat Static Water Level: $J \not 2 \not 2 \not y$ feet a Method of Measurement (circle one) Well depth: $I \not 3 \not 3$ Well grouted to a c Casing length: $I \not 3 \not 3$ feet Screen length: feet feet Screen slot size: $O , O \not i$ inches	ter used for drilling: $___$ $+_$ $+_$ $+_$ $+_$ $+_$ $+_$ $+_$	$\frac{e K}{e + v + 5 + 0 + c + c + 1}$ Other:

The sketch below only required for water wells

Description of formations encountered must be provided for all wells and boreholes, unless specifically exempted by regulations

	From (depth)	To (depth)
Description of Formations Encountered	Ground Level	51
San A	Ground Level	
600		100
· class	55	177
cont	64	14
c.lay.		81
6.04	89	<u> </u>
clan	90	/31
	13/	139
604	136	132
Sand	157	169
606	169	215
clau		221
coal		230
Llay		
		
ž.		
·		
	·	

If more than one screen, show location of each on sketch

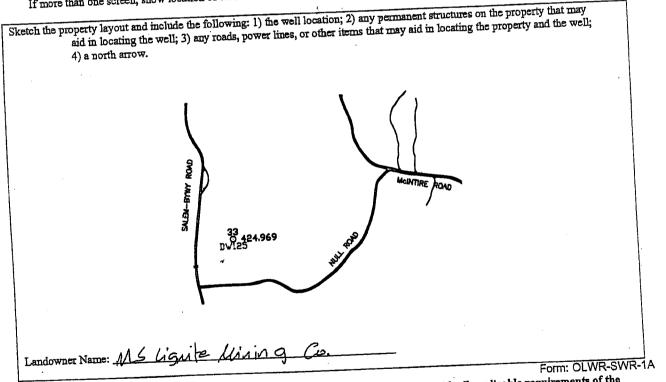

I certify that the well/borehole was drilled, constructed, and completed in accordance with all applicable requirements of the Mississippi Department of Environmental Quality and the Mississippi Department of Health regulations, if applicable, and state

3-26-08 laws Kondy SAIErs Mille 0779 GM Date

Print Name of Responsible Licensee and License No.

Signature of Licensee

DW125

County: <u>Choldres</u> Permit #: Driller: <u>Randy Sclers</u> Date completed: <u>3-26.08</u> <u>Copy information from block on Part 1</u> This part of the report must be complete report must be attached and both parts Well Owner Inform Owner Name: <u>MS Lignite</u> Mailing Address: <u>1000 M. Zahir</u>	Pump Installer' Mississippi Departme Office of Land P.O. Jackson, 1 (601) (601) (601) ded by a licensed water well filed with the Department nation	at the above address within 30 d We Latitude: <u>33^c 3 3 '11, 68''</u>	lays of well completion. Il Location Longitude:_99 °15' 35,	
Ackernan MS 39735 City State Zip Code Telephone No. (462) 387-5200		Method of Lat/Long (check one): Conventional Survey, USGS quad, Hand-held GPS, Survey-grade GPS[$\underline{N} \underline{W} \underline{4} \underline{N'} \underline{W} \underline{K'}$ Sec T[$\underline{J} \underline{M} \underline{R} \underline{I} \underline{O} \underline{L}$ Distance Direction Nearest Town $\underline{D} \underline{S} \underline{N'} \underline{M'}$ of $\underline{C} \underline{H} \underline{e} \underline{J} \underline{e} \underline{I} \underline{C} \underline{I}$		
Pump Type Circle one		Power Type Circle one		
Air Lift Jet Bucket Piston	Submersible	Diesel Engine Gasoli Electric Motor Hand	ne Engine Natural Ga Tractor PT	
Centrifugal Rotary Flowing Well Other (specify):		Windmill Other (specify): Horse Power Rating of Motor:		
Pump Test Data Date Well Tested: $3-24-03$ Static Water Level (A): 132.3 Feet Below Land Surface Pumping Water Level (B): 173 Feet Below Land Surface Drawdown [(B) - (A)]: $.571.8$ Feet Below Land Surface Test Pumping Rate: $.371.8$ Gallons Per Minute Duration of Pump Test (minimum 4 hours): $.4$		Method of Measuring Water Level Circle one Air Line Electric Measuring Line Steel Tape Other (specify):		
I HEREBY CERTIFY that the above sta <u>Rawly</u> SA/EYS MS LA Print Name of Pump Installer and Licen	= 0779 GM	of my knowledge.		

ب ب ه د ه

•