	ell Report	For Office Use Only:		
	riller's Log	Aquifer:		
	of Environmental Quality of Water Resources	Well #: D - 189		
9. 1 C / P.O. B	ox 10631 S 39289-0631	L. S. Elevation:		
, , , , , , , , , , , , , , , , , , ,	961-5210			
(601)354	1-6938 (fax)	E-log #:		
State Law requires that this report be prepared by the lice Department at the above address within 30 days of comp	letion of arming of the wen	or our criota		
Information on Well Owner	Well or Bo	rehole Location		
(Landowner if borehole is not for a water well)	Latitude: <u>33 ° ユュ 'ュラ, (</u>	3 Longitude: 85° 16 '64 80"		
Owner Name Mississippi Llywite Creek	Method of Lat/Long (circle or	ne): Conventional Survey,		
Mailing Address: 1000 Mc Instice 3 d		GPS, Survey-grade GPS		
	SW 14 NEW Sec 32	Twn 182 Rng 10E		
Ackerson As 35735 City State Zip Code	Distance Direction	Nearest Town		
Telephone No. (662) 387 - 520	2.5 Miles NW	of Chester		
Well / Bore				
Date drilling started: $(1-1/-V)^2$ Date drilling completed: $(4-1)^2$				
Location of the source of any surface water used for drilling: Method of dosing and volume of Chlorine used in drilling and devel	ttle Bywy Cres	to 500, 41 witer		
Logs run (circle all applicable): No log run Electric Gamma Ray Density Sonic Neutron Other: Name of organization running log(s): Len togy (200 ph 5:00)				
Purpose of borehole (check one): Water Well Geotechnical/Geol	ogical Investigation Groun	d Source Heat Pump		
Seismic Survey Other (<i>describe</i> If drilling is not related to water_well construction	e) n, skip the remainder of this b	lock		
Purpose of Well (check one): Home Industrial Public Supply Irrigation Fish Culture Other:				
If a flowing well, method of flow regulation: Valve C	other (describe)	7		
Static Water Level:				
Method of Measurement (circle one) steel tape electric tape air line other:				
Well depth: 188 Well grouted to a depth of 140 feet Type of grout (circle one): Neat Cement Bentonite Mix				
Casing length: 158 feet Casing diameter: 4 inches Type of casing: PVC Screen length: 40 feet Screen diameter: 4 inches Type of screen: PVC				
Screen length: 40 feet Screen diameter: 4 inches Type of screen: 100 Screen slot size: 0.01 inches Setting depth: From 150 feet to 160 feet				
Screen slot size: <u>U. U.1</u> inches Setting depth: From _ Type of completion (circle all applicable): Gravel packed Under				
Other (describe):				
Top of lap pipe or reduction in casing: feet. If telescoped or more than one screen, describe on next page				
		Form: OLWR-SWR-1A		

STATE WELL REPORT

County: Chartas

Part 2

Pump Installer's Completion Report
Mississippi Department of Environmental Quality
Office of Land and Water Resources

For Office Use Only:		
Aquifer:		
Well#:	D-184	
Elevatio	n:	

Driller: Caroly	blers	P.O. 1	Box 10631	D 194	
Date completed: 4-	11-08		MS 39289-0631	Well#: <u>D-/89</u>	
Copy information from b			961-5210 4-6938 (fax)	Elevation:	
		, ,	` ´ i		
This part of the report report must be attached	t must be completed ed and both parts fil	by a licensed water well (ed with the Denartment a	contractor or a licensed pump in It the above address within 30 da	staller. A copy of Part 1 of the	
	ell Owner Informat			Location	
Owner Name: M 5	Lignite M	inina lo	Latitude: 33 "42 52.62"	Langitude: 89 16 104 813	
•	-	12		Longitude: 89°/6 ' 10°(1,815	
Mailing Address: 1000			Method of Lat/Long (check on	e): Conventional Survey,	
Ack	erman ms	39735	USGS quad, Hand-held GPS, Survey-grade GPS/		
<u></u>			SW 4 NE 1/2 Sec 32	T18N R 10E	
City	State	Zip Code			
	202	2	Distance Direction	Nearest Town	
Telephone No. (<u>462)</u>	387-520	<i>x</i>)	2.5 Miles NW of	<u>Chester</u>	
	Pump Type			ver Type	
	Circle one		Cir	rele one	
Air Lift	Jet (Submersible	Diesel Engine Gasoline	Engine Natural Gas	
Bucket	Piston	Turbine	Electric Motor Hand	Tractor PTO	
Centrifugal	Rotary	Flowing Well	Windmill Other (s	pecify):	
Other (specify):		•	Horse Power Rating of Motor:		
Date Pump Installed:	4-14-01		Setting Depth: 153		
	•		Setting Depth:	teet	
Rated Pump Capacity:	7.4	Gallons Per Minute	Number of Stages:		
	Pump Test Data			suring Water Level	
Date Well Tested:	4-11-08		Cir	cle one	
Static Water Level (A):	//2 Rest	Relow I and Surface	Air Line Electric Meas	uring Line Steel Tape	
	: ^ .		Other (specify):		
Pumping Water Level (Below Land Surface			
Drawdown [(B) - (A)]:	Feet	Below Land Surface	For flowing well, measured shu	it in head:feet	
Test Pumping Rate:	3	Gallons Per Minute	Well yielded	GPM with a drawdown of	
Well yields 2 Of M. Willia thawtow		OF IM WILL & GRAWGOWN OF			
Duration of Pump Test (minimum 4 hours):hours			hours of pumping		
			<u> </u>		
I HERERY CEDTIEV	hat the above -t-t				
D / Care	nat the above statem	ents are true to the best of	my knowledge.	•	

I HEREBY CERTIFY that the above statements are true to the best	st of my knowledge.	
RANGES ALERS MISTIC 0779 GM	hands Salen	
Print Name of Pump Installer and License No. (if applicable)	Signature of Pump Installer	


Form: OLWR-SWR-1B

If well	telescopes,	show	depths	on sketch.

f well telescopes, show depths on sketch.			
Ground Level	K		
•			
		1	•

Description of Formations Encountered	From (depth)	To (depth)
C /ay	Ground Level	38
٢٠٩١	75	40
	40	20
	70	80
6/97	80	83
Leul	83	9/
clay	4/	1/0
	1/0	115
404	115	740
6/4/	140	147
604	1487	161
clay	161	169
2041	165	200
		1

If more than one screen, show location of each on sketch

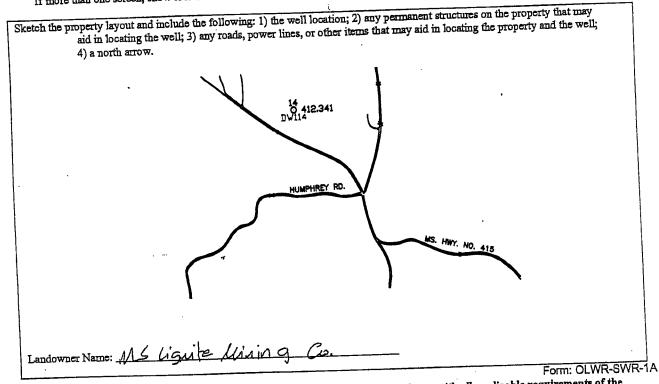

I certify that the well/borehole was drilled, constructed, and completed in accordance with all applicable requirements of the Mississippi Department of Environmental Quality and the Mississippi Department of Health regulations, if applicable, and state

RANDY SAIETS MS LIC 0779 GM 4-14-08

Signature of Licensee

Print Name of Responsible Licensee and License No.