County: Choctaw

Permit#: MS Lic 0779 GM

Driller: Randy Salers

Date drilling completed: 4/21/09

State Well Report

Part 1 – Driller's Log

Mississippi Department of Environmental Quality Office of Land and Water Resources P.O. Box 2309 Jackson, MS 39225 (601)961- 5210 (601)961- 5228 (fax)

For Office Use Only:		
Aquifer:		
L. S. Elevation:		
E-log #:		

State Law requires that this report be prepared by the license holder responsible for the work and filed with the Department at the above address within 30 days of completion of drilling of the well or borehole.

Information on Well Owner	Well or Borehole Location		
(Landowner if borehole is not for a water well)	Latitude: 33 ° 23 , 35 » Longitude: 89 ° 14 , 07 »		
Owner Name MS Lignite Mining Co			
Mailing Address: 1000 McIntire Rd	Method of Lat/Long (circle one): Conventional Survey,		
ivialing Addiess	USGS quad, Hand-held GPS, Survey-grade GPS		
	SW 1/4 NE 1/4 Sec 27 Twn 18N Rng 10E		
Ackerman MS 39735			
City State Zip Code	Distance Direction Nearest Town 2.5 Miles NW of Chester		
Telephone No. (662) 387-5200			
Well / Bore	hole Data		
Date drilling started: 4/20/09 Date drilling completed: 4/21/	09 Hele dowth, 185! Hele dismoster, 4 75"		
Location of the source of any surface water used for drilling: Li Method of dosing and volume of Chlorine used in drilling and devel	onment 1 GA1 Clorox to 500 Ga1 Water		
Logs run (circle all applicable): No log run Electric Gamma Ray Name of organization running log(s): Century Geophys:	Density Sonic Neutron Other:		
Purpose of borehole (check one): Water Well X Geotechnical/Geole	ogical Investigation Ground Source Heat Pump		
Seismic Survey Other (describe)		
If drilling is not related to water well construction			
Purpose of Well (check one): Home Industrial_X Public Supply	Irrigation Fish Culture Other:		
If a flowing well, method of flow regulation: Valve O	ther (describe)		
Static Water Level: 95.9 feet above or below (circle one) I	and surface Date measured: 4/21/09		
Method of Measurement (circle one) steel tape electric tape	air line other:		
Well depth: 185 Well grouted to a depth of 110 feet Type	of grout (circle one): Neat Cement Bentonite (Mix)		
Casing length: 125feet Casing diameter: 4	_inches Type of casing:PVC		
Screen length: 60 feet Screen diameter: 4	_inches Type of screen:PVC		
Screen slot size: 0.01 inches Setting depth: From	120feet_to180feet		
Type of completion (circle all applicable): Gravel packed Underreamed Telescoped Open hole Natural Development			
Other (describe):			
Top of lap pipe or reduction in casing:feet. <u>If tel</u>	escoped or more than one screen, describe on next page		
	Form: OLIMP SIMP 14 (04/08)		

Form: OLWR-SWR-1A (04/08)

RECEIVED


MAY 0 5 2009

BY: OLWR

If well telescopes, show depths on sketch.			
Ground Level			

Description of Formations Encountered	From (depth)	To (de	pth)
SAND	Ground Level	38]
Lignite	3₩	37	
CLAY	37	60	D-202
LIGUITE	60	Cob	10 20
CIAY	66	79	
LIGHTE	99	105	
CLAY	105	108	1
SAND	108	121	1
CIGNITÉ	121	126	1
SAND	126	/35	1
CLAY	/35	150	
SAND	150	185	
			1
			1
			1
			_
			1
			1
			1
			_
			1
			1
	<u> </u>		J

If more than one screen, show location of each on sketch

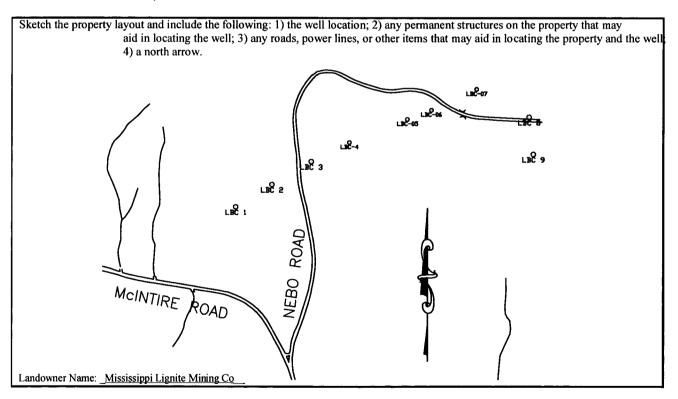

Form: OLWR-SWR-1A (04/08)

I certify that the well/borehole was drilled, constructed, and completed in accordance with all applicable requirements of the Mississippi Department of Environmental Quality and the Mississippi Department of Health regulations, if applicable, and state

Randy Salers MS lic 0779 GM

laws.

Print Name of Responsible Licensee and License No.

MAY 0 5 2009

BY: OLWR

STATE WELL REPORT

Part 2

Pump Installer's Completion Report Permit #: MS_Lic 0779 GM Mississippi Department of Environmental Quality Office of Land and Water Resources Driller: Randy Salers P.O. Box 2309 Date completed: 4/21/09

County: Choctaw

Jackson, MS 39225 (601)961-5210

For Office Use Only:			
Aquifer:			
Well #: D-202			
Elevation:			

Copy information from block on Part 1	on Part 1 (001)901-3228 (1ax)			
This part of the report must be completed by a licensed water well contractor or a licensed pump installer. A copy of Part 1 of the report must be attached and both parts filed with the Department at the above address within 30 days of well completion.				
Well Owner Information	Well Location			
Owner Name: MS Lignite Mining Co	Latitude: 33d23'35" Longitude: 89d14'07"			
Mailing Address: 1000 McIntire Rd	Method of Lat/Long (check one): Conventional Survey			
	USGS quad, Hand-held GPS, Survey-grade GPS_X_			
Ackerman MS 39735	SW 1/4 NE 1/4 Sec 27 T 18N R 10E			
City State Zip Code	Distance Direction Nearest Town			
Telephone No. (662) 387-5200	2.5 Miles NW of Chester			
Pump Type Circle one	Power Type Circle one			
Air Lift Jet Submersible	Diesel Engine Gasoline Engine Natural Gas			
Bucket Piston Turbine	Electric Motor Hand Tractor PTO			
Centrifugal Rotary Flowing Well	Windmill Other (specify):			
Other (specify):	Horse Power Rating of Motor: 0.5			
Date Pump Installed: 4/21/09	Setting Depth: 177 feet			
Rated Pump Capacity:	Number of Stages:			
Pump Test Data	Method of Measuring Water Level Circle one			
Date Well Tested: 4/21/09				
Static Water Level (A): 95.9 Feet Below Land Surface				
Pumping Water Level (B): 177 Feet Below Land Surface	Other (specify):			
Drawdown [(B) – (A)]: 81.1 Feet Below Land Surface	For flowing well, measured shut in head:feet			
Test Pumping Rate: 15 Gallons Per Minute	Well yielded 15 GPM with a drawdown of			
m cm m () ; 41) 4 1 m	81.1feet after4hours of pumping			
Duration of Pump Test (minimum 4 hours):4 hours				

I HEREBY CERTIFY that the above statements are true to the best of my knowledge.

Randy Salers MS Lic 0779

Print Name of Pump Installer and License No. (if applicable)

Randy Sales Signature of Pump Installer

Form: OLWING TO THE D

MAY 0 5 2009

BY: OLWR