| County: Choctaw | | | | |
|----------------------------------|----|-----|------|----|
| Permit #: | MS | Lic | 0779 | GM |
| Driller: Randy Salers | | | | |
| Date drilling completed: 4/25/09 | | | | |
| | | | | |

State Well Report

Part 1 – Driller's Log

Mississippi Department of Environmental Quality Office of Land and Water Resources P.O. Box 2309 Jackson, MS 39225 (601)961- 5210 (601)961- 5228 (fax)

| For Office Use Only: | | | | |
|----------------------|--|--|--|--|
| Aquifer: 7 m2 | | | | |
| Well #: 10-203 | | | | |
| L. S. Elevation: | | | | |
| E-log #: | | | | |

State Law requires that this report be prepared by the license holder responsible for the work and filed with the Department at the above address within 30 days of completion of drilling of the well or borehole.

| Department at the above dadress within 30 days of comp | iction of unuing of the well of borehote. | | | | |
|--|--|--|--|--|--|
| Information on Well Owner | Well or Borehole Location | | | | |
| (Landowner if borehole is not for a water well) | 22 . 23 . 45 | | | | |
| Owner Name_MS Lignite Mining Co | Latitude: 33 ° 23 , 45 " Longitude: 89 ° 14 , 20 " | | | | |
| Mailing Address: 1000 McIntire Rd | Method of Lat/Long (circle one): Conventional Survey, | | | | |
| | USGS quad, Hand-held GPS Survey-grade GPS | | | | |
| - | SE 1/4 NW 1/4 Sec 27 Twn 18N Rng 10E | | | | |
| Ackerman MS 39735 | 74 500 IWI Riig | | | | |
| City State Zip Code | Distance Direction Nearest Town 2.5 Miles NW of Chester | | | | |
| Telephone No. (662) 387-5200 | 2.5 Miles 111 of Chescer | | | | |
| Well / Bore | pole Nata | | | | |
| | | | | | |
| Date drilling started $\frac{4}{23}$ Date drilling completed: $\frac{4}{25}$ | 09 Hole depth: 205 Hole diameter: 4.75 | | | | |
| Location of the source of any surface water used for drilling: Li | ttle ByWy | | | | |
| Method of dosing and volume of Chlorine used in drilling and develo | opment: 1 GAl Clorox to 500 Gal Water | | | | |
| | | | | | |
| Logs run (circle all applicable): No log run Electric Gamma Ray Name of organization running log(s): | Density Sonic Neutron Other: | | | | |
| Purpose of borehole (check one): Water Well Geotechnical/Geold | ogical Investigation Ground Source Heat Pump | | | | |
| Seismic Survey Other (describe) | | | | | |
| If drilling is not related to water well construction | | | | | |
| | | | | | |
| Purpose of Well (check one): Home Industrial X Public Supply Irrigation Fish Culture Other: | | | | | |
| If a flowing well, method of flow regulation: Valve Other (describe) | | | | | |
| Static Water Level: 113.8 feet above or below (circle one) land surface Date measured: 4/25/09 | | | | | |
| Method of Measurement (circle one) steel tape electric tape air line other: | | | | | |
| Well depth: 205 Well grouted to a depth of 160 feet Type | of grout (circle one): Neat Cement Bentonite Mix | | | | |
| Casing length: 170feet Casing diameter: 4 | _inches Type of casing:PVC | | | | |
| Screen length: 35feet Screen diameter: 4inches Type of screen: PVC | | | | | |
| Screen slot size: 0.01 inches Setting depth: From | 165 feet to 200 feet | | | | |
| Type of completion (circle all applicable): Gravel packed Underreamed Telescoped Open hole Natural Development | | | | | |
| Other (describe): | | | | | |
| Top of lap pipe or reduction in casing:feet. If teld | | | | | |
| · | | | | | |

Form: OLWR-SWR-1A (04/08)

RECEIVED MAY 0 5 2009

BY: OLWR

STATE WELL REPORT

Part 2

Permit #: MS Lic 0779 GM

Driller: Randy Salers

County: Choctaw

Date completed: 4/25/09

Copy information from block on Part 1

Pump Installer's Completion Report
Mississippi Department of Environmental Quality
Office of Land and Water Resources
P.O. Box 2309
Jackson, MS 39225
(601)961-5210
(601)961-5228 (fax)

| For Office Use Only: | | | | |
|----------------------|--|--|--|--|
| Aquifer: | | | | |
| well #: D-203 | | | | |
| Elevation: | | | | |

This part of the report must be completed by a licensed water well contractor or a licensed pump installer. A copy of Part 1 of the report must be attached and both parts filed with the Department at the above address within 30 days of well completion. **Well Owner Information** Well Location Latitude: 33d23'45" Longitude: 89d14'20" Owner Name: MS Lignite Mining Co Mailing Address:_1000 McIntire Rd Method of Lat/Long (check one): Conventional Survey_____, USGS quad____, Hand-held GPS___, Survey-grade GPS_X SW $_{1/4}$ NW $_{1/4}$ Sec 27 $_{T}$ 18N $_{R}$ 10E Ackerman MS 39735 City State Zip Code Direction Nearest Town Distance Telephone No. (662) 387-5200 2.5 Miles NW of Chester

| | Pump Type Circle one | | | Power Type Circle one | |
|--------------------------------------|-------------------------|---------------------|---------------------|--------------------------|-------------|
| Air Lift | Jet | Submersible | Diesel Engine | Gasoline Engine | Natural Gas |
| Bucket | Piston | Turbine | Electric Motor | Hand | Tractor PTO |
| Centrifugal | Rotary | Flowing Well | Windmill | Other (specify): | |
| Other (specify): Mr. He Well NO Rump | | | Horse Power Rating | of Motor: | |
| Date Pump Installed: | | | Setting Depth: | | feet |
| Rated Pump Capacity: _ | 49 | _Gallons Per Minute | Number of Stages: _ | | |

| Pump Test Data | Method of Measuring Water Level Circle one | | |
|---|--|--|--|
| Date Well Tested: 4/25/09 | Air Line Electric Measuring Line Steel Tape | | |
| Static Water Level (A): 113.8 Feet Below Land Surface | Other (specify): | | |
| Pumping Water Level (B):Feet Below Land Surface | Cincl (specify). | | |
| Drawdown [(B) – (A)]:Feet Below Land Surface | For flowing well, measured shut in head:feet | | |
| Test Pumping Rate:Gallons Per Minute | Well yieldedGPM with a drawdown of | | |
| Duration of Pump Test (minimum 4 hours):hours | feet afterhours of pumping | | |

| LHERE | BY CERTIFY | that the above | statements are tru | e to the best | of my knowledg | e |
|--------|-------------|----------------|--------------------|---------------|-----------------|-----|
| LILLAD | DI CERIII I | mat me above | Statements are un | ie m nie dezi | LOLIHA KHOWICUS | ιс. |

Randy Salers MS Lic 0779 GM

Print Name of Pump Installer and License No. (if applicable)

Rond Sales Signature of Pump Installer

Form: OLWR-PAEBENVED

MAY 0 5 2009

BY: OLWR

| The sketch | below | only | <u>required</u> | <i>for</i> | water wells |
|------------|-------|------|-----------------|------------|-------------|
| | | | | | |


If well telescopes, show depths on sketch.

Ground Level

Description of formations encountered must be provided for all wells and boreholes, unless specifically exempted by regulations

| Description of Formations Encountered | From (depth) | To (der | th) |
|---------------------------------------|--------------|---------|-------------|
| | Ground Level | · | |
| | | | |
| | | | $ L\rangle$ |
| | | | |
| , | | | |
| NO LOG RIM | | | |
| 7 000.010 | | | |
| | | | |
| | | | |
| | i | | |
| | | | |
| | | | |
| | 1 | | |

If more than one screen, show location of each on sketch

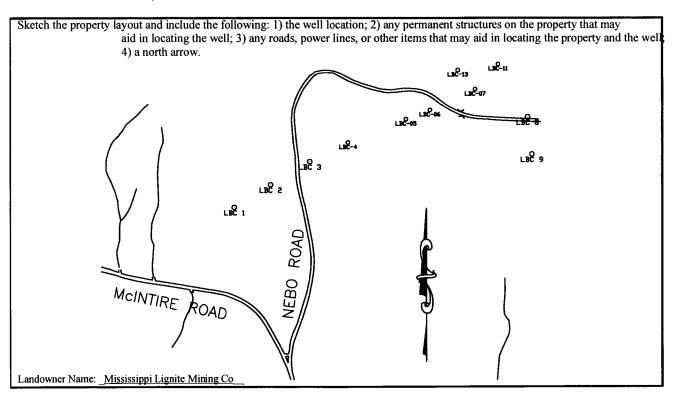

Form: OLWR-SWR-1A (04/08)

I certify that the well/borehole was drilled, constructed, and completed in accordance with all applicable requirements of the Mississippi Department of Environmental Quality and the Mississippi Department of Health regulations, if applicable, and state

| laws. | | |
|--|---------|-----------------------|
| Randy Salers MS lic 0779 GM | 4-25-09 | Kandy Salera-0-11/15 |
| Print Name of Responsible Licensee and License No. | Date | Signature of Licensee |

MAY 0 5 2009

BY: OLWR