County: Choctaw		
Permit#: MS Lic 0779		
Driller: Randy Salers		
Date drilling completed: 5/27/09		

State Well Report

Part 1 - Driller's Log

Mississippi Department of Environmental Quality
Office of Land and Water Resources
P.O. Box 2309
Jackson, MS 39225
(601)961- 5210
(601)961- 5228 (fax)

For Office Use Only:	
Aquifer: _	
Well #:	Dall
L. S. Eleva	tion:
E-log #:	

State Law requires that this report be prepared by the license holder responsible for the work and filed with the Department at the above address within 30 days of completion of drilling of the well or borehole.

Information on Well Owner	Well or Borehole Location		
(Landowner if borehole is not for a water well)	Latitude: 33 ° 23 ° ,14 " Longitude: 89 ° 14 ° ,59 "		
Owner Name MS Lignite Mining Co			
Mailing Address: 1000 McIntire Rd	Method of Lat/Long (circle one): Conventional Survey,		
	USGS quad, Hand-held GPS, Survey-grade GPS		
	NW 1/4 SW 1/4 Sec 27 Twn 18N Rng 10E		
Ackerman MS 39735	SW 5F 28		
City State Zip Code	SW 5E 28 Distance Direction Nearest Town 2.5 Miles NW of Chester		
Telephone No. (662) 387-5200	2.5 Miles NW of Chescer		
Well / Bore			
Date drilling started: 5/25/0 pate drilling completed: 5/27	/ 09 Hole depth: 150 Hole diameter: 4.75		
Location of the source of any surface water used for drilling: Li	ttle ByWy		
Method of dosing and volume of Chlorine used in drilling and devel	opment: 1 GAI Clorox to 500 Gal Water		
Logs run (circle all applicable): No log run Electric Gamma Ray Density Sonic Neutron Other: Name of organization running log(s): Century Geophysical Corp.			
Purpose of borehole (check one): Water Well_X Geotechnical/Geole	ogical Investigation Ground Source Heat Pump		
Seismic Survey Other (describe			
If drilling is not related to water well construction	n, skip the remainder of this block		
Purpose of Well (check one): Home Industrial_X Public Supply Irrigation Fish Culture Other:			
If a flowing well, method of flow regulation: Valve O	ther (describe)		
Static Water Level: 38.2 feet above or below (circle one) land surface Date measured: 5/27/09			
Method of Measurement (circle one) steel tape electric tape	air line other:		
Well depth: 150 Well grouted to a depth of 50 feet Type of grout (circle one): Neat Cement Bentonite Mix			
Casing length: 98 feet Casing diameter: 4 inches Type of casing: PVC			
Screen length: 50 feet Screen diameter: 4 inches Type of screen: PVC			
Screen slot size: 0.01 inches Setting depth: From _	100feet tofeet		
Type of completion (circle all applicable): Gravel packed Underreamed Telescoped Open hole Natural Development			
Other (describe):			
Top of lap pipe or reduction in casing:feet. If tell	lescoped or more than one screen, describe on next page		

Form: OLWR-SWR-1A (04/08)

RECEIVED
JUN 12200
BY: OLVVR

The sketch below only required for water wells


If well telescopes,	show	depths	oņ	sketch.	
Ground Level-					

* Note: Well destroyed by dragline Bunch failure.

<u>Description of formations encountered must be pr</u>ovided for all wells and boreholes, unless specifically exempted by regulations

Description of Formations Encountered	From (depth)	To (depth)
	Ground Level	
	0.000	
		
·		
	· · · · · · · · · · · · · · · · · · ·	
	<u> </u>	
	 	

If more than one screen, show location of each on sketch

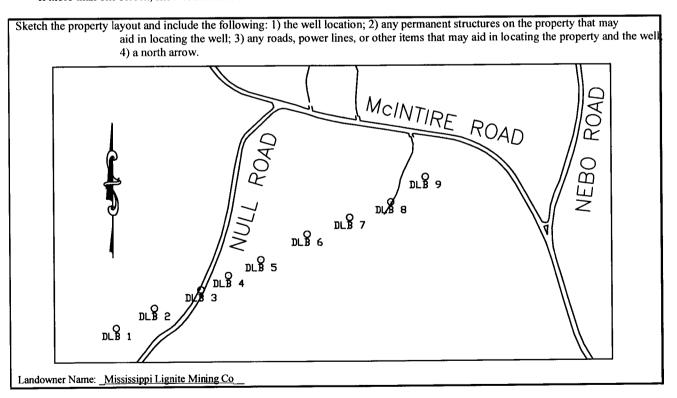

Form: OLWR-SWR-1A (04/08)

I certify that the well/borehole was drilled, constructed, and completed in accordance with all applicable requirements of the Mississippi Department of Environmental Quality and the Mississippi Department of Health regulations, if applicable, and state laws.

Randy Salers MS lic 0779 GM	

5-37.09

Date

Kandy Saleis

Signature of Licelisee 1 2 2003

BY: OLIVE

STATE WELL REPORT

Part 2

Permit #: MS Lic 0779 GM

Permit #: MS Lic 0779 GM

Driller: Randy Salers

Pump Installer's Completion Report

Mississippi Department of Environmental Quality

Office of Land and Water Resources

P.O. Box 2309

County: Choctaw

Date completed:

5/27/09

P.O. Box 2309 Jackson, MS 39225 (601)961-5210 (601)961-5228 (fax)

For Office Use Only:		
Aquifer:		
Well #:		
Elevation:		

Copy information from block on Part 1 (601)961-5228 (fax)

This part of the report must be completed by a licensed water well contractor or a licensed pump installer. A copy of Part 1 of the

report must be attached and both parts filed with the Department a	t the above address within 30 days of well completion.
Well Owner Information	Well Location
Owner Name: MS Lignite Mining Co	Latitude: 33 ' 23 ' 17 Longitude: 89 ' 14 ' 51
Mailing Address: 1000 McIntire Rd	Method of Lat/Long (check one): Conventional Survey,
	USGS quad, Hand-held GPS, Survey-grade GPS_X
Ackerman MS 39735	NW 4 SW 4 Sec 27 T 18N R 10E
City State Zip Code	NW 4 SW 4 Sec 27 T 18N R 10E SW SE Distance Direction Nearest Town
Telephone No. (662) 387-5200	ofChester
Pump Type	Power Type
Circle one	Circle one
Air Lift Jet Submersible	Diesel Engine Gasoline Engine Natural Gas
Bucket Piston Turbine	Electric Motor Hand Tractor PTO
Centrifugal Rotary Flowing Well	Windmill Other (specify):
Other (specify):	Horse Power Rating of Motor:0.5
Date Pump Installed: 5/27/09	Setting Depth: 140 feet
Rated Pump Capacity:Gallons Per Minute	Number of Stages:
Pump Test Data	Method of Measuring Water Level Circle one
Date Well Tested: 5/27/09	
Static Water Level (A): 38.2 Feet Below Land Surface	Air Line Electric Measuring Line Steel Tape
Pumping Water Level (B): 140 Feet Below Land Surface	Other (specify):
Drawdown [(B) – (A)]: 101.8 Feet Below Land Surface	For flowing well, measured shut in head:feet
Test Pumping Rate:3Gallons Per Minute	Well yielded 3GPM with a drawdown of
Duration of Pump Test (minimum 4 hours): 4 hours	101.8feet after4hours of pumping
I HEREBY CERTIFY that the above statements are true to the best of	of my knowledge.
Randy Salers MS Lic 0779 GM Print Name of Pump Installer and License No. (if applicable)	Signature of Pump Installer
	Form: OLWR-SWR B (04/08)

JUN 12 2009