
	State V	Vell Report			
County: Choctaw	Part 1 – 1	Driller's Log	For Office Use Only:		
Permit#: MS Lic 0779	Mississippi Departme Office of Land a	nt of Environmental Quality	Aquifer:		
Driller: Randy Salers	Office of Land and Water Resources P.O. Box 2309		Well #: 2 D223		
Date drilling completed: 7/3/09		n, MS 39225 1961- 5210	L. S. Elevation:		
Sino dinning completed.	(601)961- 5228 (fax)		E-log #: _		
State Law requires that this report	t be prepared by the lic	ense holder responsible for i	the work and Glad with the		
Department at the above address Information on Well C	within 30 days of com	pletion of drilling of the well	or borehole.		
(Landowner if borehole is not for a water well)			rehole Location		
Owner Name MS Lignite Mining Co			" Longitude: 89. 15, 33 "		
Mailing Address: 1000 McIntire Rd		Method of Lat/Long (circle one): Conventional Survey,			
			GPS, Survey-grade GPS		
Ackerman MS	39735	SW 1/4 SW 1/4 Sec 28	Twn_18N Rng_10E		
City State		Distance Direction	Nearest Town		
Telephone No. (662) 387-5200		2.5 Miles NW	of Chester		
	Well / Bore	hala Data			
Data deilling starts 4 6/16/09	7/3/	09 105			
Date drilling started: Date dril	ling completed:	Hole depth: 195	Hole diameter: 4.75		
Location of the source of any surface water used for drilling: Little ByWy Method of dosing and volume of Chlorine used in drilling and development: 1 GA1 Clorox to 500 Gal Water					
Logs run (circle all applicable): No log run Electric Gamma Ray Density Sonic Neutron Other: Name of organization running log(s): Century Geophysical Corp.					
Purpose of borehole (check one): Water Well X Geotechnical/Geological Investigation Ground Source Heat Pump					
Seismic Su	rvey Other (describe)				
		, skip the remainder of this bloc			
Purpose of Well (check one): Home Industrial _X Public Supply Irrigation Fish Culture Other: If a flowing well, method of flow regulation: Valve Other (describe)					
1.60	Valve Otl	ner (describe)			
Static Water Level: 160 feet above or below (circle one) land surface Date measured: 7/3/09					
Method of Measurement (circle one) steel tape electric tape air line other:					
Well depth: 195 Well grouted to a depth	h offeet Type o	of grout (circle one): Neat Cemer	nt Bentonite Mix		
Casing length:feet Casing diameter:inches Type of casing: PVC					
Screen length: 30feet Screen diameter: 4inches Type of screen: PVC					
Screen slot size: 0.01 inches	Setting depth: From	160feet to10	90 feet		
Type of completion (circle all applicable): Gravel packed Underreamed Telescoped Open hole Natural Development					
Other (describe):					
Top of lap pipe or reduction in casing:					
			Form: OLWR-SWR-1A (04/08)		

RECEIVED

JUL 2 4 2009

BY: OLWR

The sketch below only required for water wells	Description of formations encountered must be provided for all wells and boreholes, unless specifically exempted by regulations			
If well telescopes, show depths on sketch. Ground Level	Description of Formations Encountered	From (depth)	To (depth)	
		Ground Level		
			-	
				
				
If more than one screen, show location of each on sketch				

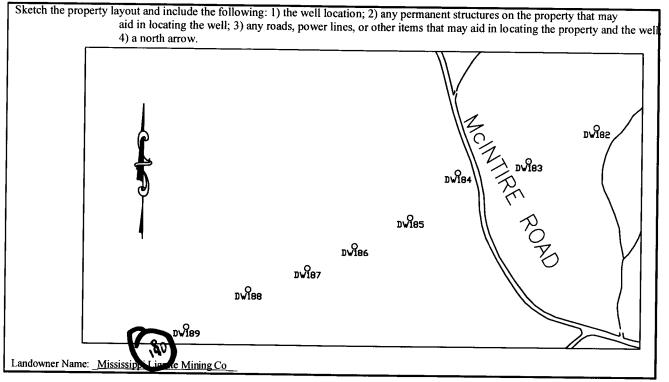

Form: OLWR-SWR-1A (04/08)

I certify that the well/borehole was drilled, constructed, and completed in accordance with all applicable requirements of the
Mississippi Department of Environmental Quality and the Mississippi Department of Health regulations, if applicable, and state
laws.

Randy Salers MS lic 0779 GM	7-3-09	RECEIVE
Print Name of Responsible Licensee and License No.	Date	Signature of Licensee

JUL 2 4 2009

BY: OLWR

STATE WELL REPORT

County: Choctaw Permit#: MS Lic 0779 GM

Driller: Randy Salers

Date completed: 7/3/09

Copy information from block on Part 1

Telephone No. (662) 387-5200

Part 2

Pump Installer's Completion Report Mississippi Department of Environmental Quality Office of Land and Water Resources P.O. Box 2309 Jackson, MS 39225

(601)961-5210 (601)961-5228 (fax)

For Office Use Only:		
Aquifer:		
Well #: D223		
Elevation:		

of Chester

This part of the report must be completed by a licensed water well contractor or a licensed pump installer. A copy of Part 1 of the report must be attached and both parts filed with the Department at the above address within 30 days of well completion. Well Owner Information Well Location Latitude: 33*23'23___Longitude: 89*15'32 Owner Name: MS Lignite Mining Co Mailing Address: 1000 McIntire Rd Method of Lat/Long (check one): Conventional Survey____ USGS quad____, Hand-held GPS___, Survey-grade GPS X SW 1/2 SW 1/2 Sec 29 T 18N R 10E Ackerman MS 39735 City State Zip Code Distance Direction Nearest Town

2.5 Miles NW

Pump Type Power Type Circle one Circle one Air Lift Jet Submersible Diesel Engine Gasoline Engine Natural Gas Bucket Piston Turbine Electric Motor Hand Tractor PTO Centrifugal Rotary Flowing Well Windmill Other (specify): ___ Other (specify): 0.5 Horse Power Rating of Motor: Date Pump Installed: 7/3/09 Setting Depth: 180 Rated Pump Capacity: ___ Gallons Per Minute Number of Stages:

Pump Test Data Method of Measuring Water Level Date Well Tested: 7/3/09 Circle one Air Line Electric Measuring Line Steel Tape Static Water Level (A): 160 Feet Below Land Surface Other (specify): Pumping Water Level (B): 180 Feet Below Land Surface Drawdown [(B)-(A)]: 20Feet Below Land Surface For flowing well, measured shut in head: _____ feet Test Pumping Rate: 3 Gallons Per Minute Well yielded 3 GPM with a drawdown of Duration of Pump Test (minimum 4 hours): feet after 4 hours of pumping

I HEREBY CERTIFY that the above statements are true to the best of my knowledge.

Randy Salers MS Lic 0779 GM

Print Name of Pump Installer and License No. (if applicable)

Signature of Pump Installer

Form: OLWR-SWR-18 (FO) FIVED