	State W	Vell Report	<u> </u>	
County: Choctaw	Part 1 – Driller's Log		For Office Use Only:	
Permit #: MS Lic 0779	Mississippi Department of Environmental Quality Office of Land and Water Resources		Aquifer:	
Driller: Randy Salers	P.O. Box 2309		Well #:	
Date drilling completed: 7/8/09	Jackson, MS 39225 (601)961- 5210		L. S. Elevation:	
Date driffing completed:	, ,	1- 5228 (fax)		
State Law requires that this report	t be prepared by the lic	ense holder responsible for t	E-log #:	
Depuriment at the above address	within 30 days of comp	pletion of drilling of the well	or borehole.	
Information on Well O (Landowner if borehole is not fo	wner <i>r a water well</i> )		rehole Location	
Owner Name MS Lignite Min	•	Latitude: 33 • 23 , 32 " Longitude: 89 • 15, 11 "		
Mailing Address: 1000 McIntire	e Rd	Method of Lat/Long (circle one): Conventional Survey,		
		. /	GPS, Survey-grade GPS	
Ackerman MS	39735	NW 1/4 SE 1/4 Sec 28	Twn_18N Rng_10E	
City State		Distance Direction 2.5 Miles NW	Nearest Town	
Telephone No. (662) 387-5200		MilesIW	of Chester	
	Well / Bore	hole Data		
Date drilling started: 6/30/09 ate dril				
			Hole diameter: 4.75	
Location of the source of any surface water Method of dosing and volume of Chlorine	used for drilling: Li used in drilling and develo	ttle ByWy  ppment: 1 GAl Cloro	x to 500 Gal Water	
Logs run (circle all applicable): No log run Name of organization running log(s): Cer.	Electric Gamma Ray ntury Geophysi	Density Sonic Neutron C	Other:	
Purpose of borehole (check one): Water Wei	ll_X Geotechnical/Geolo	gical Investigation Ground	Source Heat Pump	
Seismic Survey Other (describe)				
		skip the remainder of this bloc		
Purpose of Well (check one): Home Inc	lustrial_X Public Supply_	IrrigationFish Culture _	Other:	
If a flowing well, method of flow regulation:	Valve Ot	her (describe)		
Static Water Level:161feet above or below (circle one) land surface Date measured:7/8/09				
Method of Measurement (circle one) steel tape electric tape air line other:				
Well depth: Well grouted to a depth of feet Type of grout (circle one): Neat Cement Bentonite Mix				
Casing length: 235 feet Casing diameter: 4 inches Type of casing: PVC				
Screen length: 45 feet Screen	diameter: 4	_inches Type of screen:		
Screen slot size: 0.01 inches Setting depth: From 230 feet to 275 feet				
Type of completion (circle all applicable): Gravel packed Underreamed Telescoped Open hole Natural Development				
Other (describe):				
Top of lap pipe or reduction in casing:				
			Form: OLWR-SWR-1A (04/08)	


**RECEIVED** 

JUL 2 4 2009

BY: OLWR

e sketch below only required for water wells well telescopes, show depths on sketch.	Description of formations encountered must be provided for wells and boreholes, unless specifically exempted by regulations			
Ground Level	Description of Formations Encountered	From (depth)	To (depth	
		Ground Level		
		<del></del>		

If more than one screen, show location of each on sketch

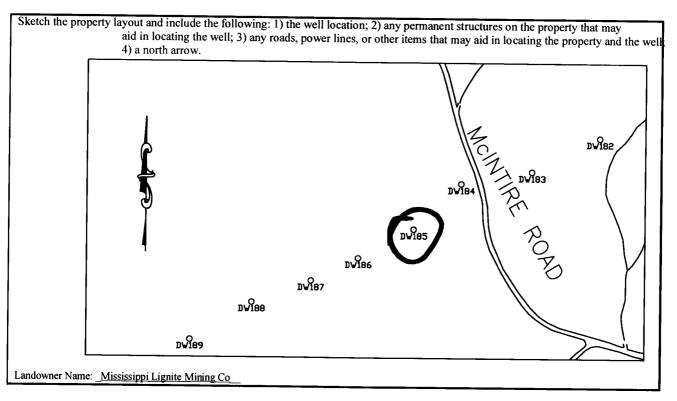

Form: OLWR-SWR-1A (04/08)

I certify that the well/borehole was drilled, constructed, and con	npleted in accordance with all applicable requirements of the
Mississippi Department of Environmental Quality and the Miss	issippi Department of Health regulations, if applicable, and state
laws.	

laws.	<b>U</b> 21 26	
Randy Salers MS lic 0779 GM	7-8-09	
Print Name of Responsible Licensee and License No.	Date	Signature of Licensee ECEIVED
		•

JUL 2 4 2009

BY: OLWR

## STATE WELL REPORT

## Part 2

Permit #: MS Lic 0779 GM Pump Installer
Mississippi Department

Driller: Randy Salers

Date completed: 7/8/09

County: Choctaw

Copy information from block on Part 1

Pump Installer's Completion Report
Mississippi Department of Environmental Quality
Office of Land and Water Resources
P.O. Box 2309
Jackson, MS 39225
(601)961-5210
(601)961-5228 (fax)

For Office Use Only:		
Aquifer:		
Well #:	8	
Elevation:		

This part of the report must be completed by a licensed water well contractor or a licensed pump installer. A copy of Part 1 of the report must be attached and both parts filed with the Department at the above address within 30 days of well completion. **Well Owner Information** Well Location Latitude: 33\*23'32 Longitude: 89\*15'11 Owner Name: MS Lignite Mining Co Mailing Address: 1000 McIntire Rd Method of Lat/Long (check one): Conventional Survey\_\_\_\_, USGS quad\_\_\_\_\_, Hand-held GPS\_\_\_\_, Survey-grade GPS\_X NW 1/4 SE 1/4 Sec 29 T 18N R 10E Ackerman MS 39735 City Zip Code Direction 28 Distance Nearest Town Telephone No. (662) 387-5200 2.5 Miles NW of Chester

	Pump Type Circle one			Power Type Circle one	
Air Lift	Jet	Submersible	Diesel Engine	Gasoline Engine	Natural Gas
Bucket	Piston	Turbine	Electric Motor	Hand	Tractor PTO
Centrifugal	Rotary	Flowing Well	Windmill	Other (specify):	
Other (specify):			Horse Power Rating	g of Motor: 0.5	
Date Pump Installed:	7/8/09		Setting Depth: 26		feet
Rated Pump Capacity:		Gallons Per Minute	Number of Stages:		

**Pump Test Data** Method of Measuring Water Level Circle one Date Well Tested: 7/8/09 Air Line **Electric Measuring Line** Static Water Level (A): 161 Steel Tape Feet Below Land Surface Other (specify): Pumping Water Level (B): 265 Feet Below Land Surface Drawdown [(B) – (A)]: \_\_\_\_ Feet Below Land Surface For flowing well, measured shut in head: \_\_\_\_ Test Pumping Rate: 3 Gallons Per Minute Well yielded 3 \_ GPM with a drawdown of 104 Duration of Pump Test (minimum 4 hours): feet after 4 hours of pumping

I HEREBY CERTIFY that the above statements are true to the best of	my knowledge.
Randy Salers MS Lic 0779 GM Print Name of Pump Installer and License No. (if applicable)	Signature of Pump Installer

Form: OLWR-SWR-1 PECEIVED