

### State Well Report Part 1 - Driller's Log

Mississippi Department of Environmental Quality  
Office of Land and Water Resources  
P.O. Box 10631  
Jackson, MS 39289-0631  
(601)961-5210  
(601)354-6938 (fax)

County: Choctaw  
 Permit #: \_\_\_\_\_  
 Driller: D. Warren  
 Date drilling completed: 10/14/09

**For Office Use Only:**  
 Aquifer: D 236  
 Well #: \_\_\_\_\_  
 L. S. Elevation: \_\_\_\_\_  
 E-log #: \_\_\_\_\_

**State Law requires that this report be prepared by the license holder responsible for the work and filed with the Department at the above address within 30 days of completion of drilling of the well or borehole.**

Information on Well Owner (Landowner if borehole is not for a water well)	Well or Borehole Location
Owner Name <u>MS Lignite Mining Company</u>	Latitude: <u>33 ° 23 ' 41 "</u> Longitude: <u>89 ° 14 ' 51 "</u>
Mailing Address: <u>1000 McIntire Road</u>	Method of Lat/Long (circle one): Conventional Survey, USGS quad, Hand-held GPS, Survey-grade GPS
<u>Ackerman</u> MS <u>39735</u>	<u>SW ¼ NW ¼ Sec 27 Twn 18N Rng 10E</u>
City State Zip Code	Distance Direction Nearest Town <u>5</u> Miles <u>NW</u> of <u>Ackerman</u>
Telephone No. <u>(662) 387-5200</u>	

**Well / Borehole Data**

Date drilling started: 10/14/09 Date drilling completed: 10/14/09 Hole depth: 245 Hole diameter: 8 in.

Location of the source of any surface water used for drilling: Creek Water

Method of dosing and volume of Chlorine used in drilling and development: 1 gal per 500 gal water

Logs run (circle all applicable): (No log run) Electric Gamma Ray Density Sonic Neutron Other: \_\_\_\_\_

Name of organization running log(s): Century Wireline - Pilot Borings, E-log

Purpose of borehole (check one): Water Well  Geotechnical/Geological Investigation \_\_\_ Ground Source Heat Pump \_\_\_  
 Seismic Survey \_\_\_ Other (describe) \_\_\_\_\_

***If drilling is not related to water well construction, skip the remainder of this block***

Purpose of Well (check one): Home \_\_\_ Industrial \_\_\_ Public Supply \_\_\_ Irrigation \_\_\_ Fish Culture \_\_\_ Other: De-water

If a flowing well, method of flow regulation: Valve \_\_\_\_\_ Other (describe) \_\_\_\_\_

Static Water Level: 180.4 feet above or below (circle one) land surface Date measured: 3/12/10

Method of Measurement (circle one) steel tape (electric tape) air line other: \_\_\_\_\_

Well depth: 245 Well grouted to a depth of 205 feet Type of grout (circle one): Neat Cement Bentonite (Mix)

Casing length: 205 feet Casing diameter: 4 inches Type of casing: PVC

Screen length: 40 feet Screen diameter: 4 inches Type of screen: PVC

Screen slot size: 0.01 inches Setting depth: From 200 feet to 240 feet

Type of completion (circle all applicable): (Gravel packed) Underreamed Telescoped Open hole Natural Development  
 Other (describe): \_\_\_\_\_

Top of lap pipe or reduction in casing: \_\_\_\_\_ feet. ***If telescoped or more than one screen, describe on next page***

Form: OLWR-SWR-1A


**RECEIVED**  
**APR 01 2010**  
**BY: OLWR**


D 236

The sketch below only required for water wells

Description of formations encountered must be provided for all wells and boreholes, unless specifically exempted by regulations

If well telescopes, show depths on sketch.


Ground Level 

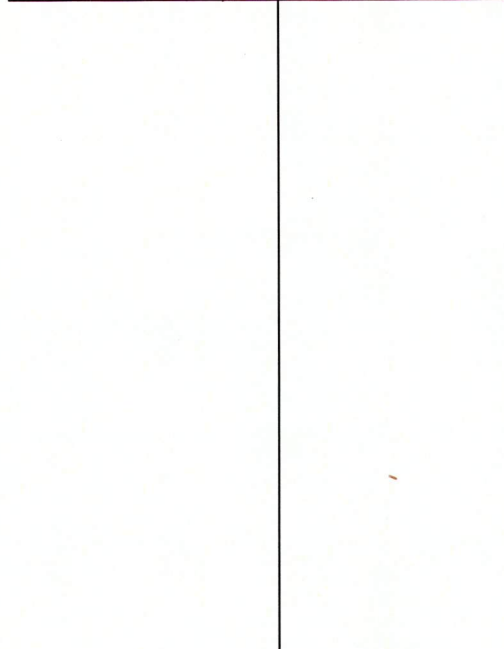

Description of Formations Encountered	From (depth)	To (depth)
	Ground Level	
WILCOX FORMATION	0	245

If more than one screen, show location of each on sketch

Sketch the property layout and include the following: 1) the well location; 2) any permanent structures on the property that may aid in locating the well; 3) any roads, power lines, or other items that may aid in locating the property and the well; 4) a north arrow.

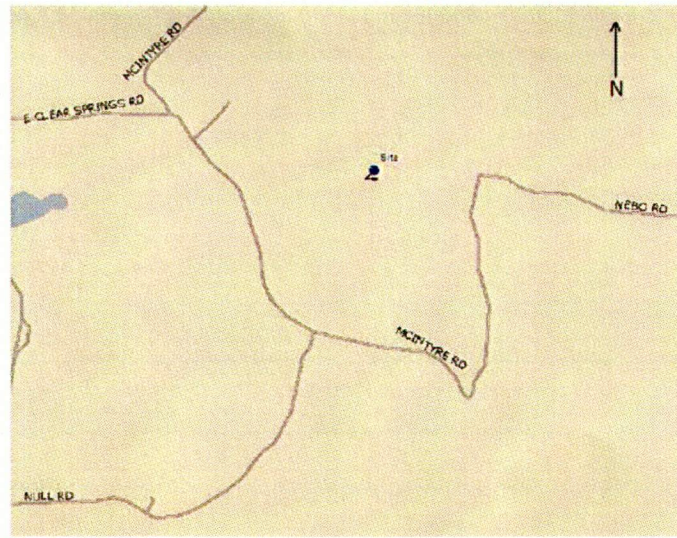

Landowner Name: MS Lignite Mining Company

Form: OLWR-SWR-1A

I certify that the well/borehole was drilled, constructed, and completed in accordance with all applicable requirements of the Mississippi Department of Environmental Quality and the Mississippi Department of Health regulations, if applicable, and state laws.

GOMER WALLACE 0565 3-30-2010

Print Name of Responsible Licensee and License No.

Date

Signature of Licensee

**RECEIVED**  
**APR 01 2010**  
**BY: OLWR**

# STATE WELL REPORT

## Part 2

**Pump Installer's Completion Report**  
 Mississippi Department of Environmental Quality  
 Office of Land and Water Resources  
 P.O. Box 10631  
 Jackson, MS 39289-0631  
 (601)961-5210  
 (601)354-6938 (fax)

County: \_\_\_\_\_  
 Permit #: \_\_\_\_\_  
 Driller: \_\_\_\_\_  
 Date completed: \_\_\_\_\_  
*Copy information from block on Part 1*

**For Office Use Only:**

Aquifer: D 2 36  
 Well #: \_\_\_\_\_  
 Elevation: \_\_\_\_\_

*This part of the report must be completed by a licensed water well contractor or a licensed pump installer. A copy of Part 1 of the report must be attached and both parts filed with the Department at the above address within 30 days of well completion.*

Well Owner Information	Well Location
Owner Name: _____	Latitude: _____ Longitude: _____
Mailing Address: _____ _____ _____	Method of Lat/Long (check one): Conventional Survey _____, USGS quad _____, Hand-held GPS _____, Survey-grade GPS _____ _____ ¼ _____ ¼ Sec _____ T _____ R _____
City                      State                      Zip Code	Distance                      Direction                      Nearest Town
Telephone No. ( _____ ) _____	<u>5</u> Miles <u>NW</u> of <u>Ackerman</u>

Pump Type Circle one	Power Type Circle one
Air Lift                      Jet <u>Submersible</u>	Diesel Engine                      Gasoline Engine                      Natural Gas
Bucket                      Piston                      Turbine	<u>Electric Motor</u> Hand                      Tractor PTO
Centrifugal                      Rotary                      Flowing Well	Windmill                      Other (specify): _____
Other (specify): _____	Horse Power Rating of Motor: _____
Date Pump Installed: _____	Setting Depth: _____ feet
Rated Pump Capacity: <u>5</u> Gallons Per Minute	Number of Stages: _____

Pump Test Data	Method of Measuring Water Level Circle one
Date Well Tested: _____	Air Line                      Electric Measuring Line                      Steel Tape
Static Water Level (A): _____ Feet Below Land Surface	Other (specify): _____
Pumping Water Level (B): _____ Feet Below Land Surface	For flowing well, measured shut in head: _____ feet
Drawdown [(B) - (A)]: _____ Feet Below Land Surface	Well yielded _____ GPM with a drawdown of
Test Pumping Rate: _____ Gallons Per Minute	_____ feet after _____ hours of pumping
Duration of Pump Test (minimum 4 hours): _____ hours	

I HEREBY CERTIFY that the above statements are true to the best of my knowledge.

\_\_\_\_\_  
 Print Name of Pump Installer and License No. (if applicable)

\_\_\_\_\_  
 Signature of Pump Installer

Form: **RECEIVED**  
**APR 01 2010**  
**BY: OLWR**