| | State W | ell Report | | |
|--|---|---|-----------------------------|--|
| County: Choctaw | | Priller's Log | For Office Use Only: | |
| | Mississippi Department of Environmental Quality Aquifer: | | Aquifer: 1945 | |
| Permit #: | Office of Land and Water Resources P.O. Poy 10621 Well #: | | | |
| Driller:D. Warren | 1.0. Box 10031 | | | |
| Date drilling completed: 9/29/09 | Jackson, MS 39289-0631 L. S. Elevation: | | L. S. Elevation: | |
| | | 4-6938 (fax) | E-log #: | |
| State Law requires that this report Department at the above address | t be prepared by the lice | ense holder responsible for t Jetion of drilling of the well | he work and filed with the | |
| Information on Well (| Owner | | rehole Location | |
| (Landowner if borehole is not for | or a water well) | Latituda: 33 º 23 · 41 | " Longitude: 89 • 14 , 51 " | |
| Owner Name MS Lignite Mining | Company | Latitude. 33 23 11 | Longitude. 22 22 | |
| Mailing Address: 1000 McIntire R | oad | Method of Lat/Long (circle on | e): Conventional Survey, | |
| Mailing Address: 1000 McIntire Road | | USGS quad, Hand-held GPS, Survey-grade GPS | | |
| | | SW 1/4 NW 1/4 Sec 27 | Twn 18N Rng 10E | |
| Ackerman MS | | | | |
| City Stat | te Zip Code | Distance Direction 5 Miles NW | | |
| Telephone No. (662) 387-5200 | | Miles | or renerman | |
| | Well / Bore | hole Data | | |
| Date drilling started: 9/29/09 Date dr | illing completed: 9/29 | 09 Hole depth: 225 | Hole diameter: 8 in. | |
| Location of the source of any surface water | er used for drilling: C | reek Water | | |
| Method of dosing and volume of Chlorine | | | gal water | |
| Logs run (circle all applicable): No log run | Electric Gamma Ray | Density Sonic Neutron (| Other: | |
| Name of organization running log(s): Cer | tury Wireline - | Pilot Borings, E-lo | g | |
| Purpose of borehole (check one): Water W | ell X Geotechnical/Geolo | ogical Investigation Ground | Source Heat Pump | |
| Seismic Survey Other (<i>describe</i>) | | | | |
| If drilling is not related to water well construction, skip the remainder of this block | | | | |
| Purpose of Well (check one): Home Industrial Public Supply Irrigation Fish Culture Other: _De-water_ | | | | |
| If a flowing well, method of flow regulation: Valve Other (describe) | | | | |
| Static Water Level: 97.9 feet above or below (circle one) land surface Date measured: 3/12/10 | | | | |
| Method of Measurement (circle one) steel tape electric tape air line other: | | | | |
| Well depth: 225 Well grouted to a depth of 155 feet Type of grout (circle one): Neat Cement Bentonite Mix | | | | |
| Casing length: 165 feet Casing diameter: 4 inches Type of casing: PVC | | | | |
| Screen length: 60 feet Screen diameter: 4 inches Type of screen: PVC | | | | |
| Screen slot size: 0.01 inches | Setting depth: From | 160 feet to 2 | 20 feet | |
| Type of completion (circle all applicable): | Gravel packed Under | reamed Telescoped Open | hole Natural Development | |
| Other (describe): | | | | |
| Top of lap pipe or reduction in casing: feet. If telescoped or more than one screen, describe on next page | | | | |
| | | | Form: OLWR-SWR-1A | |

The sketch below only required for water wells


| I | f well | telescopes | s, | show | depths | on | sketch. | |
|---|--------|------------|----|------|--------|----|---------|--|
| | Gra | and I eve | 1 | | | | | |

Description of formations encountered must be provided for all wells and boreholes, unless specifically exempted by regulations

| Description of Formations Encountered | From (depth) | To (depth) |
|---------------------------------------|--------------|------------|
| | Ground Level | |
| WILCOX FORMATION | 0 | 225 |
| WIEGOII I GIURIII GIV | | |
| | | |
| | 11 | |
| | <u> </u> | |
| | | |
| | | |
| | | |
| | | |
| | | , |
| | | |
| | | |
| | | 1 |
| | | |
| | | |
| | 1 | |
| | | |
| | | |
| | | -1 13 |
| | | |
| | | |

If more than one screen, show location of each on sketch

Sketch the property layout and include the following: 1) the well location; 2) any permanent structures on the property that may aid in locating the well; 3) any roads, power lines, or other items that may aid in locating the property and the well; 4) a north arrow.

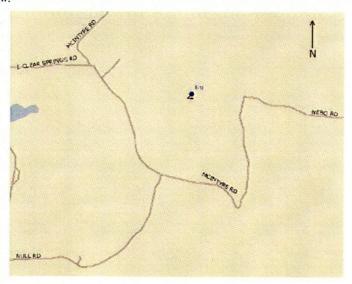

Landowner Name: MS Lignite Mining Company

Form: OLWR-SWR-1A

I certify that the well/borehole was drilled, constructed, and completed in accordance with all applicable requirements of the Mississippi Department of Environmental Quality and the Mississippi Department of Health regulations, if applicable, and state laws.

GOMER WALLACE

Print Name of Responsible Licensee and License No.

Signature of Licensee

STATE WELL REPORT

County:

Part 2
Pump Installer's Completion Report

| For Office Use Only: | | | | |
|----------------------|---|-----|--|--|
| Aquifer: | D | 245 | | |
| Well #: | , | | | |
| Elevation: | | | | |

| | ent of Environmental Quality Aquifer: Aquifer: |
|--|--|
| Driller: P.O. | Box 10631 |
| Date completed: | MS 39289-0631 Well #: |
| | 1)961-3210 54-6938 (fax) Elevation: |
| | |
| This part of the report must be completed by a licensed water well report must be attached and both parts filed with the Department | |
| Well Owner Information | Well Location |
| Owner Name: | Latitude:Longitude: |
| Mailing Address: | Method of Lat/Long (check one): Conventional Survey, |
| | USGS quad, Hand-held GPS, Survey-grade GPS |
| | |
| City State Zip Code | |
| | Distance Direction Nearest Town |
| Telephone No. () | 5 Miles NW of Ackerna |
| Pours Torre | D. T. T. |
| Pump Type Circle one | Power Type Circle one |
| Air Lift Jet Submersible | Diesel Engine Gasoline Engine Natural Gas |
| Bucket Piston Turbine | Electric Motor Hand Tractor PTO |
| Centrifugal Rotary Flowing Well | Windmill Other (specify): |
| Other (specify): | Horse Power Rating of Motor: |
| Date Pump Installed: | Setting Depth:feet |
| Rated Pump Capacity: Gallons Per Minute | Number of Stages: |
| Pump Test Data | Method of Measuring Water Level |
| Date Well Tested: | Circle one |
| | Air Line Electric Measuring Line Steel Tape |
| Static Water Level (A):Feet Below Land Surface | Other (specify): |
| Pumping Water Level (B):Feet Below Land Surface | |
| Drawdown [(B) – (A)]:Feet Below Land Surface | For flowing well, measured shut in head:feet |
| Test Pumping Rate:Gallons Per Minute | Well yieldedGPM with a drawdown of |
| Duration of Pump Test (minimum 4 hours):hours | feet afterhours of pumping |
| | |
| I HEREBY CERTIFY that the above statements are true to the best | of my knowledge. |
| | |
| Print Name of Pump Installer and License No. (if applicable) | Signature of Pump Installer Form: OLWR-SWR-1B |

APR 0 1 2010