BY: OLWR

	State We	ell Report					
County: Choctaw			For Office Use Only:				
		of Environmental Quality	Aquifer: <u>D246</u>				
Permit #:	Office of Land and Water Resources P.O. Box 10631		Well #:				
Driller: D. Warren		S 39289-0631	L. S. Elevation:				
Date drilling completed: 9/28/09		061-5210					
	(601)354	-6938 (fax)	E-log #:				
State Law requires that this repo	ort be prepared by the lice.	nse holder responsible for a	the work and filed with the				
Department at the above addres	s within 30 days of compl	letion of drilling of the well	or borehole.				
Information on Well Owner (Landowner if borehole is not for a water well) Owner Name MS Lignite Mining Company		Well or Borehole Location Latitude: <u>33° 23' 41</u> " Longitude: <u>89° 14' 51</u> " Method of Lat/Long (circle one): Conventional Survey,					
				Mailing Address: 1000 McIntire Road			
						USGS quad, Hand-held	GPS, Survey-grade GPS
		<u>SW</u> 1/4 NW 1/4 Sec 27	Twn 18N Rng 10E				
Ackerman M City St	AS 39735		Nearest Town				
	5		Distance Direction Nearest Town 5 Miles NW of Ackerman				
Telephone No. (662) 387-5200							
	Well / Boreh	ole Data					
D. 1.111		00.00.00.00.00.00					
Date drilling started: $9/28/09$ Date d	rilling completed: 9/20/	09 Hole depth: 210	Hole diameter: 8 1n.				
Location of the source of any surface wa							
Method of dosing and volume of Chlorin	ne used in drilling and develo	pment: <u>1 gal per 500</u>	gal water				
Logs run (circle all applicable): No log ru	Electric Gamma Ray	Density Sonic Neutron	Other:				
Name of organization running log(s):_Ce	ntury Wireline - 1	Pilot Borings, E-lo	g				
Purpose of borehole (check one): Water V	Well X Geotechnical/Geolo	gical Investigation Ground	Source Heat Pump				
	SurveyOther (describe) d to water well construction	, skip the remainder of this bl	ock				
Purpose of Well (check one): Home							
If a flowing well, method of flow regulati	on: Valve Oth	her (describe)					
Static Water Level: <u>117.6</u> feet a	bove or below (circle one) la	and surface Date measured:	3/12/10				
Method of Measurement (circle one)	steel tape electric tape	air line other:					
Well depth: <u>210</u> Well grouted to a d	lepth of <u>150</u> feet Type of	of grout (circle one): Neat Cem	ent Bentonite Mix				
Casing length: 160 feet Cas	ing diameter: 4	inches Type of casing:	PVC				
Screen length: <u>50</u> feet Scr							
Screen slot size: 0.01 inches							
Type of completion (circle all applicable)	: Gravel packed Underro	eamed Telescoped Open	hole Natural Development				
	Other (describe):						
Top of lap pipe or reduction in casing:							
			Form: OLWR-SWR-				
			APR 0 1 2010				

.

4


1.

The sketch below only required for water wells

If well telescopes, show depths on sketch. Ground Level_____ Description of formations encountered must be provided for all wells and boreholes, unless specifically exempted by regulations

Description of Formations Encountered	From (depth) To (depth)	
and a second day of the second se	Ground Level	
WILCOX FORMATION	0	210
		-
		-

If more than one screen, show location of each on sketch

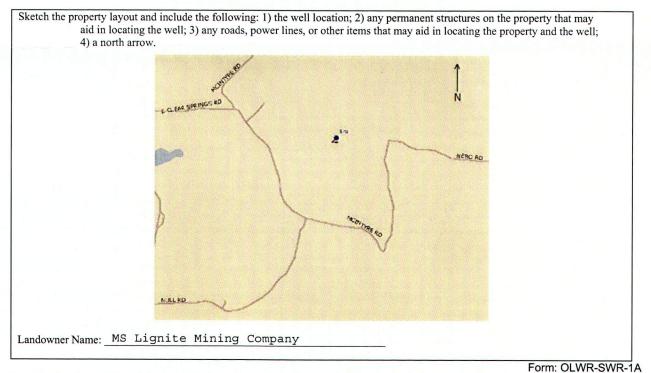

I certify that the well/borehole was drilled, constructed, and completed in accordance with all applicable requirements of the Mississippi Department of Environmental Quality and the Mississippi Department of Health regulations, if applicable, and state laws.

Date

GOMER WALLACE 0565 3-30-2010

Somer Waller

Print Name of Responsible Licensee and License No.

Signature of Licensee



	STATE WI	ELL REPORT		
County.		Part 2	For Office Use Only:	
Permit #:	Pump Installer's Completion Report Mississippi Department of Environmental Quality Office of Land and Water Resources P.O. Box 10631 Jackson, MS 39289-0631 (601)961-5210		Aquifer: D 246	
Driller:			- D c l a	
Date completed:			Well #:	
Copy information from block on Part 1		54-6938 (fax)	Elevation:	
This part of the report must be completed b	by a licensed water well	contractor or a licensed pump i	nstaller. A copy of Part 1 of the	
report must be attached and both parts filed with the Department Well Owner Information		Well Location		
Owner Name:		Latitude: Longitude:		
Mailing Address:		Method of Lat/Long (check one): Conventional Survey,		
		USGS quad, Hand-held GPS, Survey-grade GPS		
		¹ / ₄ ¹ / ₄ Sec		
City State	Zip Code		Nearest Town	
		5 Miles NW o	Δ.	
Telephone No. ()				
Ритр Туре			wer Type	
Circle one	74 L L 27 L L	C	ircle one	
Air Lift Jet O	Submersible	Diesel Engine Gasolin	ne Engine Natural Gas	
Bucket Piston	Turbine	Electric Motor Hand	Tractor PTO	
Centrifugal Rotary	Flowing Well	Windmill Other	(specify):	
Other (specify):	<u></u>	Horse Power Rating of Motor	:	
Date Pump Installed:		Setting Depth:	feet	
Rated Pump Capacity: 5	Gallons Per Minute	Number of Stages:		
Pump Test Data			easuring Water Level	
Date Well Tested:		the second s		
Static Water Level (A):Feet Below Land Surface				
Pumping Water Level (B):Feet E	Below Land Surface	Outer (specify):		
Drawdown [(B) – (A)]:Feet H	Below Land Surface	For flowing well, measured sl	nut in head:feet	
Test Pumping Rate:	Gallons Per Minute	Well yielded	GPM with a drawdown of	

I HEREBY CERTIFY that the above statements are true to the best of my knowledge.

Print Name of Pump Installer and License No. (if applicable)

Signature of Pump Installer

APR 0 1 2010 BY: OLWR