

CHOCTAW MISSISSIPPI BOARD OF WATER COMMISSIONERS

E 3

4-8-65

WATER WELL DRILLERS LOG CODED


Date: 4-8-1965, Driller: MERRITT DRILLING County CHOCTAW
(Name)

		Description & Color of Materials Sand, Clay, Red Clay, Shell, etc.	Thick- ness Feet	Depth Feet
(1) Owner of Land: <u>BARBARA RAYNES</u> (Name)		TOP. Soil	0	18
<u>RT-2-Ackerman, Miss.</u> (Address)		LIGNITE	10	13
(2) Location: <u>17 1/4</u> Sec. <u>18 1/4</u> T. <u>11</u> R.		GRAY CLAY	13	15
<u>8</u> miles <u>NORTH</u> of <u>Ackerman</u> (distance) (direction) (Nearest Town)		GREEN CLAY	15	20
(3) Topography: <u>Hilly</u> (Hilly) (Flat) (Level)		Blue Gumbo	20	24
(4) Purpose of Well: <u>DOMESTIC</u> (Domestic Irrigation Municipal, Industrial, Other)		LIGNITE	24	25
		Blue Gumbo	25	48
		LIGNITE	48	50
		Blue Gumbo	50	57
		LIGNITE	57	58
		Blue Gumbo	58	62
		LIGNITE	62	64
		GRAY CLAY	64	79
		LIGNITE	79	84
		Blue CLAY	84	98
		ROCK 4"		
		Blue CLAY	98	107
		LIGNITE	107	109
		Blue CLAY	109	111
		Blue SAND	111	116
		Blue CLAY	116	118
		LIGNITE	118	120
(6) Were any formations sealed against pollution? _____ yes, _____ no.		SOFT. Blue CLAY	120	134
		LIGNITE	134	137
		Blue CLAY	137	164
		LIGNITE	164	166
		Blue CLAY	166	181
		FINE Blue SAND	181	183
		Blue CLAY	183	192
		LIGNITE	192	195
		Blue CLAY	195	226
		Gray SAND	225	260

Information upon completion of well:

- (1) Diameter 2 inches.
- (2) Total Depth 260 feet.
- (3) Water Level 120 feet below top of ground.
- (4) Cased to 252, Size 2
- (5) Screen: Size 1/4", Length 6'
- (6) Were any formations sealed against pollution?
_____ yes, _____ no.

If YES depth of formation _____
Why _____
Drillers Remarks: _____

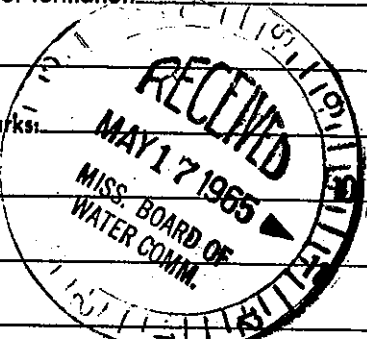

(Use Back Side)

Well No.

Mail this copy to Board of Water Commissioners 429 Miss. St. Jackson, Miss.