

CHOCTAW MISSISSIPPI BOARD OF WATER COMMISSIONERS

E⁶

8-2-60

WATER WELL DRILLERS LOG CODED ?

Date: 8-2, 1960, Driller: J. H. McDonald County Choctaw
(Name)

(1) Owner of Land: <u>Mrs. T. H. Dudley</u> <small>(Name)</small>	Description & Color of Materials Sand, Clay, Red Clay, Shell, etc.	Thick- ness Feet	Depth Feet
<u>Ackerman, Miss.</u> <small>(Address)</small>	<u>Red clay</u>	<u>30</u>	<u>30</u>
(2) Location: <u>1/4, 19, 18 11</u> <small>1/4, Sec. T R</small>	<u>Blue clay</u>	<u>10</u>	<u>40</u>
<u>2</u> miles <u>north</u> of <u>Ackerman</u> <small>(distance) (direction) (Nearest Town)</small>	<u>Black lignite</u>	<u>3</u>	<u>43</u>
(3) Topography: <u>Hilly</u> <small>(Hilly) (Flat) (Level)</small>	<u>Blue shell</u>	<u>167</u>	<u>210</u>
(4) Purpose of Well: <u>Domestic</u> <small>(Domestic Irrigation Municipal, Industrial, Other)</small>	<u>Blue Grey sand</u>	<u>40</u>	<u>250</u>


Information upon completion of well:

- (1) Diameter 2 inches.
- (2) Total Depth 240 feet.
- (3) Water Level 150 feet below top of ground.
- (4) Cased to 210 ft., Size 2"
- (5) Screen: Size Open, Length _____
- (6) Were any formations sealed against pollution?
Yes yes, _____ no.

If YES depth of formation 40 ft.

Why Lignite formation

Drillers Remarks: Red formation set casing 2" on 3' so closed it with 3" casing to prevent same from happening.

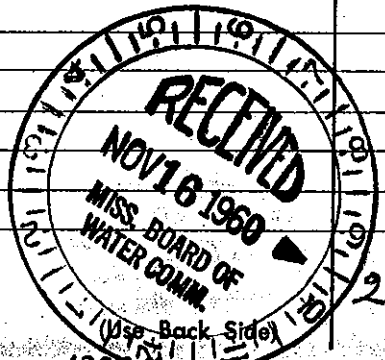

Well No. _____