

~~8-2-63~~ **E 9** WATER WELL DRILLERS LOG

Date: 8-2-, 19 63, Driller: MERRITT DRILLING COMPANY CHOCTAW  
(Name)

(1) Owner of Land: <u>T.A. Pennix</u> (Name) <u>MATHISTON, MISS</u> (Address)	Description & Color of Materials Sand, Clay, Red Clay, Shell, etc.	Thick- ness Feet	Depth Feet
(2) Location: <u>1/4</u> , <u>18 11</u> <u>T</u> <u>R</u> <u>5</u> miles <u>south</u> of <u>MATHISTON</u> (distance) (direction) (Nearest Town)	<u>Red clay</u>	<u>0</u>	<u>5</u>
(3) Topography: <u>HILLY</u> (Hilly) (Flat) (Level)	<u>Yellow sand</u>		
(4) Purpose of Well: <u>DOMESTIC</u> (Domestic Irrigation Municipal, Industrial, Other)	<u>Sand rock</u>	<u>5</u>	<u>25</u>
	<u>Granite</u>	<u>25</u>	<u>28</u>
	<u>Blue clay</u>	<u>18</u>	<u>35</u>
	<u>Blue sand</u>	<u>35</u>	<u>42</u>

Information upon completion of well:

(1) Diameter 2 inches.

(2) Total Depth 42 feet.

(3) Water Level 18 feet below top of ground.

(4) Cased to 34, Size 2"


(5) Screen: Size 1 1/4", Length 6'

(6) Were any formations sealed against pollution?  
no

If YES depth of formation \_\_\_\_\_

Why \_\_\_\_\_

Drillers Remarks: \_\_\_\_\_

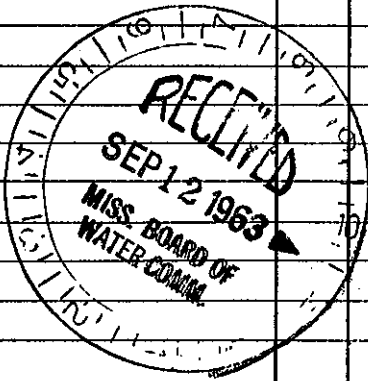

(Use Back Side)

Well No.

Mail this copy to Board of Water Commissioners 429 Miss. St. Jackson, Miss.