

CHOCTAW MISSISSIPPI BOARD OF WATER COMMISSIONERS


~~4-28-65~~ E 11

WATER WELL DRILLERS LOG

CODED

Date: 4-28, 1965, Driller: Merritt Drilling Co., Choctaw  
(Name)

(1) Owner of Land: <u>Thomas Jones</u> (Name)	Description & Color of Materials Sand, Clay, Red Clay, Shell, etc.	Thick- ness Feet	Depth Feet
<u>RT # 3, Ackerman, Miss.</u> (Address)	Red Clay	0	14
(2) Location: <u>1/4, 18 18 11</u> T R	Lignite	14	18
<u>5</u> miles <u>South</u> , of <u>Mathiston</u> (distance) (direction) (Nearest Town)	Blue Clay	18	20
(3) Topography: <u>Hilly</u> (Hilly) (Flat) (Level)	Lignite	20	28
(4) Purpose of Well: <u>DOMESTIC</u> (Domestic Irrigation Municipal, Industrial, Other)	FINE WHITE SAND	28	32
Information upon completion of well:	Blue clay	32	44
(1) Diameter <u>2</u> inches.	Lignite	44	47
(2) Total Depth <u>189</u> feet.	GREEN CLAY	47	75
(3) Water Level <u>90</u> feet below top of ground.	SOFT Blue clay	75	85
(4) Cased to <u>182</u> " Size <u>2"</u>	SOFT Green clay	85	95
(5) Screen: Size <u>1 1/4"</u> Length <u>5'</u> <u>STAINLESS STEEL</u>	Blue clay	95	99
(6) Were any formations sealed against pollution? <u>yes</u>	Lignite + Blue clay	99	111
If YES depth of formation _____	Blue clay	111	134
Why _____	GALY SAND	134	189
Drillers Remarks: _____			

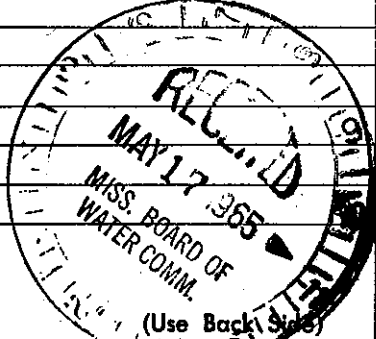

Well No.

Mail this copy to Board of Water Commissioners 429 Miss. St. Jackson, Miss.