

CHOCTAW MISSISSIPPI BOARD OF WATER COMMISSIONERS

~~B~~ E 13


WATER WELL DRILLERS LOG

5-18-65

CODED

Date: 5.18, 1965, Driller: MERRITT Dalling County, CHOCTAW
(Name)

(1) Owner of Land:	Description & Color of Materials Sand, Clay, Red Clay, Shell, etc.	Thick- ness Feet	Depth Feet
(Name) Jessie GAMBler	TOP SOIL	0	2
(Address) R.T. 2, Ackerman, Miss	White Clay	2	15
(2) Location: 1/4, 18 18 11, Sec. T R	Blue Gumbo	15	30
(distance) 4 miles South, (direction) of Morthuston, (Nearest Town)	LIGNITE	30	33
(3) Topography: Hilly (Hilly) / Flat (Flat) / Level (Level)	GREEN CLAY	33	35
(4) Purpose of Well: DOMESTIC (Domestic Irrigation, Municipal, Industrial, Other)	Blue Clay	35	65
Information upon completion of well:	LIGNITE	65	67
(1) Diameter: 2 inches.	Blue clay	67	79
(2) Total Depth: 273 feet.	Thin Rock	79	96
(3) Water Level: 80 feet below top of ground.	SOFT Blue Clay	79	96
(4) Cased to: 265, Size: 2	LIGNITE	96	98
(5) Screen: Size: 1 1/4, Length: 6'	Blue clay	98	117
(6) Were any formations sealed against pollution? yes, <input checked="" type="checkbox"/> no.	LIGNITE	117	118
If YES depth of formation	Blue Clay	118	122
Why	LIGNITE	122	124
Drillers Remarks:	Blue Clay	124	170
	Blue sand & clay	170	175
	Blue clay	175	185
	Blue sand	185	190
	Blue clay	190	213
	Sand & clay	213	219
	Blue clay	219	237
	Thin Rock	237	239
	Blue sand	237	239
	Thin Rock	239	273
	Grey sand	239	273

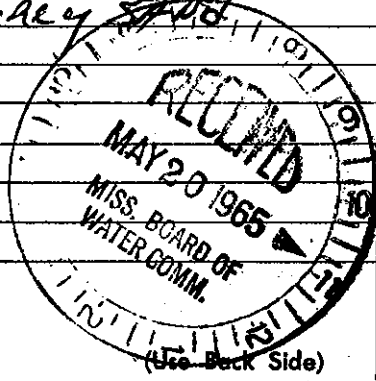

Well No.

Mail this copy to Board of Water Commissioners 429 Miss. St. Jackson, Mis: