

CHOCTAW MISSISSIPPI BOARD OF WATER COMMISSIONERS

~~5-27-65~~ **E14**

WATER WELL DRILLERS LOG

CODED

5-27-65

Date: 5-27, 1965, Driller: MERRITT DAINING CO County CHOCTAW
(Name)


(1) Owner of Land: Jessie Gamble
(Name)
Rt #2 Ackerman, Miss.
(Address)
17 18 11
(2) Location: 1/4, 1/4, Sec. T R
5 miles South, of Madison
(distance) (direction) (Nearest Town)
(3) Topography: Hilly
(Hilly) (Flat) (Level)
(4) Purpose of Well: Domestic
(Domestic Irrigation, Municipal, Industrial, Other)

Description & Color of Materials Sand, Clay, Red Clay, Shell, etc.	Thick- ness Feet	Depth Feet
Top Soil	0	2
White Clay	2	15
Blue Gumbo	15	30
LIGNITE	30	33
Green Clay	33	35
Blue Clay	35	65
LIGNITE	65	67
Blue Clay	67	79
Thin Rock		
SOFT Blue Clay	79	96
LIGNITE	96	98
SOFT Blue clay	98	117
LIGNITE	117	118
Blue clay	118	122
LIGNITE <u>CODED</u>	122	124
Blue clay	124	170
Blue clay & SAND	170	175
Blue Clay	175	185
Blue SAND	185	190
Blue clay	190	215
Blue SAND	215	219
Blue clay	219	237
Thin Rock		
GRAY SAND	237	273

Information upon completion of well:

(1) Diameter 2 inches.
(2) Total Depth 273 feet.
(3) Water Level 100 feet below top of ground.
(4) Cased to 265, Size 2
(5) Screen: Size 1/4, Length 6'
(6) Were any formations sealed against pollution?
yes, no.

If YES depth of formation _____
Why _____
Drillers Remarks: _____

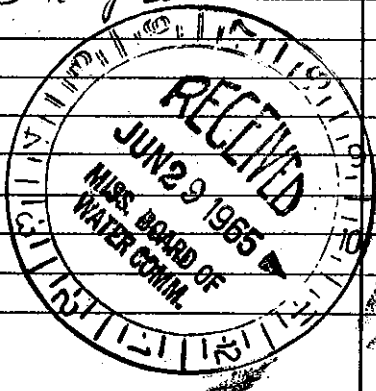

Well No. _____

(Use Back Side)

Mail this copy to Board of Water Commissioners 429 Miss. St. Jackson, Mis: