

CHOCTAW MISSISSIPPI BOARD OF WATER COMMISSIONERS

~~6~~ E 15


6-26-65

WATER WELL DRILLERS LOG

CODED

Date: 6-26, 1965, Driller: MERRITT DRILLING County CHOCTAW  
(Name)

(1) Owner of Land: <u>J.A. CORK</u> (Name)	Description & Color of Materials Sand, Clay, Red Clay, Shell, etc.	Thick- ness Feet	Depth Feet
<u>Newton, Miss.</u> (Address)	<u>Red CLAY</u>	<u>0</u>	<u>3</u>
(2) Location: <u>9 18 77</u> <u>5</u> miles <u>South</u> of <u>Ackerman</u> (distance) (direction) (Nearest Town)	<u>White CLAY</u>	<u>3</u>	<u>10</u>
(3) Topography: <u>Hilly</u> (Hilly) (Flat) (Level)	<u>Gray CLAY + SAND</u>	<u>10</u>	<u>16</u>
(4) Purpose of Well: <u>DOMESTIC</u> (Domestic Irrigation Municipal, Industrial, Other)	<u>GRAY SAND</u>	<u>16</u>	<u>95</u>
Information upon completion of well:	<u>TAN SAND</u>	<u>95</u>	<u>91</u>
(1) Diameter <u>2</u> inches.	<u>White SAND</u>	<u>95</u>	<u>15.3</u>
(2) Total Depth <u>153</u> feet.			
(3) Water Level <u>90</u> feet below top of ground.			
(4) Cased to <u>147</u> , Size <u>2</u>			
(5) Screen: Size <u>1 1/4"</u> , Length <u>6'</u>			
(6) Were any formations sealed against pollution? <u>yes</u> , <input checked="" type="checkbox"/> <u>no</u> .			
If YES depth of formation _____			
Why _____			
Drillers Remarks: _____			
_____			
_____			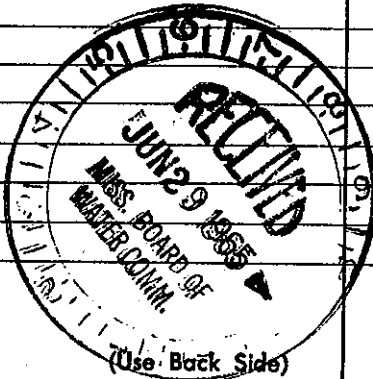
Well No.

Mail this copy to Board of Water Commissioners 429 Miss. St. Jackson, Miss.