

CHOCTAW

F 3 CODED

3-68

Miss Geo. Survey

3-25

date well completed

6078

MISSISSIPPI BOARD OF WATER COMMISSIONERS

416 North State Street

Jackson, Mississippi 39201

WATER WELL DRILLERS LOG

1968 Layne-Central Co.

firm name

ELOG# 9

CODED

Choctaw

county well located

LANDOWNER: French Camp

Water Association

French Camp, Miss.

(mailing address)

WELL LOCATION:

sec. 31 T. 17 N. R. 9 E.

(distance) miles (direction) of (nearest town)

WELL PURPOSE:

(home, irrigation, municipal, industrial)

WELL COMPLETION DATA:


- (1) diameter (inches) 10"
- (2) total depth (feet) 695
- (3) static water level (feet) 86' below top of ground.
- (4) casing Steel 6.45' (material) (depth)
- (size) if telescope see back.
- (5) screen 40' 6.50' (length) (depth to top)
- 6" Stainless Steel (size) (material)
- (6) pump 15 (HP) (yield gpm)
- Electric (type power)
- (7) electric log yes (yes or no)
- Miss. Geo. Survey (organization running log)
- (8) how well bottom plugged Valve

description of formations encountered

from to

Red Clay	0	5
Clay & Sand Strata	5	108
Sand	108	116
Sand	116	138
Sand	138	160
Sand	160	183
Sand	183	205
Sand	205	208
Clay and Sand	208	218
Sand and Clay	218	310
Clay and Sand	310	325
Clay	325	423
Clay and Sand	423	455
Rock	455	456
Sandy Clay	456	489
Hard Clay	489	496
Rock, Hard	496	498
Clay and Sand Strata	498	597
Rock	597	598
Clay and Sand Strata	598	628
Sand	628	635
Sand	635	658
Sand	658	680
Sand	680	695
Clay	695	702

CODED

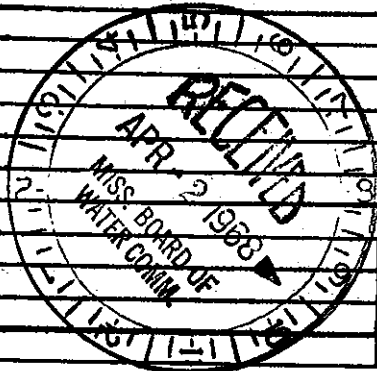

DRILLERS REMARKS: Pump not installed as of this date - no test run