

CHOCTAW

NS

F6  
2-24-62


WATER WELL DRILLERS LOG

CODED

Date: 2-24-1962, Driller: Smith & Presley County Choctaw

(Name)

(1) Owner of Land	Description & Color of Materials Sand, Clay, Red Clay, Shell, etc.	Thick- ness Feet	Depth Feet
Billy Parkerson (Name)	Few inches of top soil		
French Camp, Miss. (Address)	red sand 3 or 4 ft	4	4
(2) Location: SE 1/4, SW 1/4, Sec. 10, T17R8	white sand	9	13
west miles 4 1/2 miles of French Camp, Miss. (distance) (direction) (Nearest Town)	real coarse white sand	5	18
(3) Topography: Hilly (Hilly) (Flat) (Level)	brown sand		
(4) Purpose of Well: domestic (Domestic Irrigation Municipal, Industrial, Other)	rock yellow flake mixture	3	21
	light brown		
	coarse sand	21	42
	" " " "	4	46
	White coarse sand	10	56
Information upon completion of well:	<del>rock</del>		
(1) Diameter 2 inches.	a real coarse sand	7	63
(2) Total Depth 196 feet.	has just is a		
(3) Water level About 100 feet below top of ground.	real lite yellow		
(4) Cased to 147, Size 2"	Clay about	71	64
(5) Screen: Size 1/4, Length 12'	fine sand light		
(6) Were any formations sealed against pollution?	yellow clay mixture	36	100
yes, <input checked="" type="checkbox"/> no.	black or blue		
	Clay	16	116
	white rock about	4"	
	blue clay	44	160
	blue clay blue		
	silt mixture	13	173
	streak of blue clay	1	174
	white clay mixture		
	with a little lignite	3	177
	coarse sand with		
	white clay mixture	3	180
	white medium	16	196
	sand		

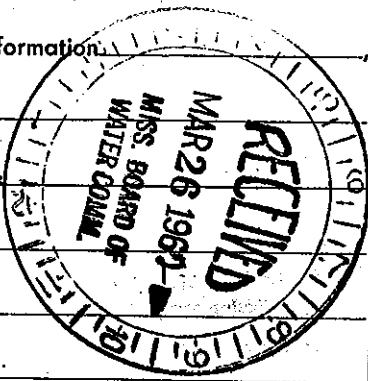

(Use Back Side)

Well No. 15

Mail this copy to Board of Water Commissioners 429 Miss. St. Jackson, Miss