

CHOCTAW
F7
8-1-62

MISSISSIPPI BOARD OF WATER COMMISSIONERS

WATER WELL DRILLERS LOG
CODED

Date: 8-1, 1962, Driller: Smith & Presley, Choctaw
D. C. Thomas (Name)

(1) Owner of Land:	Description & Color of Materials Sand, Clay, Red Clay, Shell, etc.	Thick- ness Feet	Depth Feet
(Name) <u>Modell C. Thomas</u> <u>French Camp</u> (Address)	<u>sandy loam top</u> <u>soil</u>	<u>3</u>	<u>3</u>
(2) Location: <u>SW 1/4, NB 1/4, Sec. 13, T17R8</u> <u>4</u> miles <u>French Camp</u> , of (distance) (direction) (Nearest Town)	<u>yellow clay</u> <u>blue clay</u>	<u>9</u>	<u>12</u>
(3) Topography: <u>Hilly</u> (Hilly) (Flat) (Level)	<u>blue clay & grey</u> <u>silt mixture</u>	<u>26</u>	<u>38</u>
(4) Purpose of Well: <u>Domestic</u> (Domestic Irrigation Municipal, Industrial, Other)	<u>redish sand</u> <u>white sand</u>	<u>6</u>	<u>44</u>
		<u>10</u>	<u>54</u>
		<u>60</u>	<u>114</u>


Information upon completion of well:

- (1) Diameter 2 inches.
- (2) Total Depth 114 feet.
- (3) Water Level 8 feet below top of ground.
- (4) Cased to 105, Size 2"
- (5) Screen: Size 80 mesh, Length 1/2 x 6"
- (6) Were any formations sealed against pollution?
 yes, no.

If YES depth of formation _____

Why _____

Drillers Remarks: _____

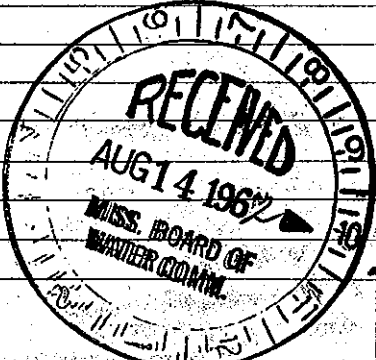

(Use Back Side)

29
27
25

Mail this copy to Board of Water Commissioners 429 Miss. St. Jackson, Miss.