

CHOCTAW

F8

9-4-62

MISSISSIPPI BOARD OF WATER COMMISSIONERS

WATER WELL DRILLERS LOG ^{CODED}

Date: 9-4-, 1962, Driller: Smith & Presley County Choctaw
(Name)

(1) Owner of Land:	Description & Color of Materials Sand, Clay, Red Clay, Shell, etc.	Thick- ness Feet	Depth Feet
<u>Milton Carter</u> (Name)	Red Clay	15	15
<u>Rt. Box 94 French Camp</u> (Address)	black & clay	19	34
(2) Location: <u>E 3/8 1/4, NW 1/4, Sec. 36 T17R8</u>	black & blue clay with green sand		
<u>1</u> miles <u>west</u> , of <u>French Camp</u> (distance) (direction) (Nearest Town)	road mixture	6	44
(3) Topography: <u>hilly</u> (Hilly) (Flat) (Level)	blue clay	10	54
(4) Purpose of Well: <u>domestic</u> (Domestic Irrigation Municipal, Industrial, Other)	green clay	9	63
	green gray green mixture	37	100
	gray sponge clay with a white shell mixture	47	147
	blue clay with a trace of sand	37	184
	fine white sand	10	194
	a belt of white sand	8	202


Information upon completion of well:

- (1) Diameter 2" inches.
- (2) Total Depth 209 feet.
- (3) Water level 50 feet below top of ground.
- (4) Cased to 206 2x1/4 Size 1
- (5) Screen: Size 1/4, Length 6'
- (6) Were any formations sealed against pollution?
_____ yes, _____ no.

If YES depth of formation _____

Why _____

Drillers Remarks: _____

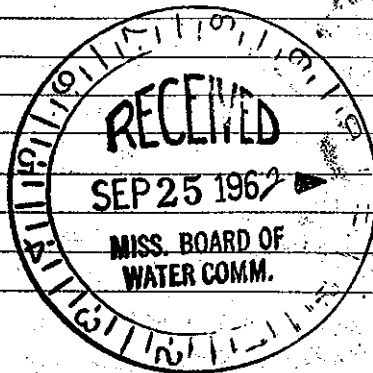

(Use Back Side)

33
No

Mail this copy to Board of Water Commissioners 429 Miss. St. Jackson, Miss