

CHOCTAW

MISSISSIPPI BOARD OF WATER COMMISSIONERS


~~DA~~ F 10  
7-11-62

WATER WELL DRILLERS LOG

RODER

Date: 7-11-, 1962, Driller: Smith & Parsley County Choctaw  
(Name)

	Description & Color of Materials Sand, Clay, Red Clay, Shell, etc.	Thick- ness Feet	Depth Feet
(1) Owner of Land: <u>Mr. R. C. Wilson</u> (Name) <u>R. 2 Stewart</u> (Address)	Yellow Clay	17	17
(2) Location: <u>NW 1/4, Sec. 10 T17 R8</u> <u>H X H 13 Stone</u> <u>3</u> miles <u>Ethubhill</u> of <u>Stewart</u> (distance) (direction) (Nearest Town)	Light yellow clay	8	25
(3) Topography: <u>Hilly</u> (Hilly) (Flat) (Level)	Red White clay	7	32
(4) Purpose of Well: <u>Domestic</u> (Domestic Irrigation Municipal, Industrial, Other)	near white clay with a trace of sand	10	42
Information upon completion of well:	white clay sand mixture	20	62
(1) Diameter <u>2"</u> inches.	sand white with white clay mix- ture	22	84
(2) Total Depth <u>163</u> feet.	white coarse blast speck mixture	21	105
(3) Water Level <u>55</u> feet below top of ground.	white sand <u>RODER</u>		
(4) Cased to <u>126</u> , Size <u>2"</u>	black speck mixture	21	126
(5) Screen: Size <u>1/4"</u> , Length <u>8'</u>	white sand with red mixture	21	147
(6) Were any formations sealed against pollution?  _____ yes, <u>X</u> no.	gray white coarse white sand	16	163
If YES depth of formation _____			
Why _____			
Drillers Remarks: _____			
_____			
_____			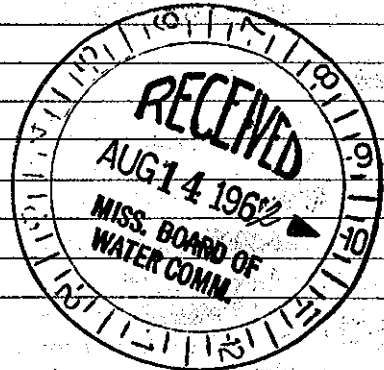
25  
Well No.

(Use Back Side)

Mail this copy to Board of Water Commissioners 429 Miss. St. Jackson, Miss