

CHOCTAW MISSISSIPPI BOARD OF WATER COMMISSIONERS

~~3-1-63~~ F11
3-1-63

WATER WELL DRILLERS LOG

CODED

Date: 3-1, 1963, Driller: J.L. Merritt County Choctaw
(Name)

(1) Owner of Land: <u>Allen Mills</u> (Name)	Description & Color of Materials Sand, Clay, Red Clay, Shell, etc.	Thick- ness Feet	Depth Feet
<u>Weir Miss</u> (Address)	<u>Red clay</u>	<u>0</u>	<u>10</u>
(2) Location: <u>1/4 10 1/4 Sec. 9 T. R.</u>	<u>PINK SAND</u>	<u>6</u>	<u>18</u>
<u>7 miles North</u> of <u>Weir</u> (distance) (direction) (Nearest Town)	<u>PINK SAND & CLAY</u>	<u>18</u>	<u>30</u>
(3) Topography: <u>Hilly</u> (Hilly) (Flat) (Level)	<u>TAN SAND</u>	<u>30</u>	<u>60</u>
(4) Purpose of Well: <u>Domestic</u> (Domestic Irrigation Municipal, Industrial, Other)	<u>White Sand</u>	<u>60</u>	<u>90</u>


Information upon completion of well:

- (1) Diameter 2 inches.
- (2) Total Depth 90 feet.
- (3) Water Level 64 feet below top of ground.
- (4) Cased to 84, Size 2"
- (5) Screen: Size 1 1/4, Length 6'
- (6) Were any formations sealed against pollution?
no

If YES depth of formation _____

Why _____

Drillers Remarks: _____

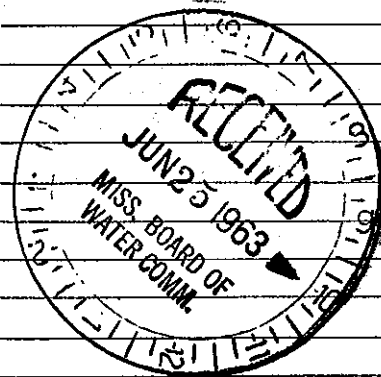

(Use Back Side)

Well No.

Mail this copy to Board of Water Commissioners 429 Miss. St. Jackson, Miss