

CHOCTAW MISSISSIPPI BOARD OF WATER COMMISSIONERS

~~000~~ F 13

WATER WELL DRILLERS LOG

CODED

11-30-64

Date: 11-30, 1964, Driller: MR. BAITT P. B. JR. DRIVING County CHOCTAW  
(Name)

(1) Owner of Land:	Description & Color of Materials Sand, Clay, Red Clay, Shell, etc.	Thick- ness Feet	Depth Feet
PAUL HENSON (Name)	Red CLAY	0	16
RT. 1. WEIR (Address)	Red SAND	16	21
4 17 9 (Location: 1/4, 1/4, Sec. T. R.)	White SAND	21	72
5 miles NORTH of WEIR (distance) (direction) (Nearest Town)	Yellow clay SAND	72	90
Hilly (Topography: (Hilly) (Flat) (Level))	Blue SAND & clay	90	120
DOMESTIC (Purpose of Well: (Domestic Irrigation) (Municipal, Industrial, Other))	Blue CLAY	120	141
	Rock	141	142
	Blue CLAY	142	147
	GREEN CLAY	147	158
	Blue SAND & shale	158	205

Information upon completion of well:

- (1) Diameter 2 inches.
- (2) Total Depth 202 feet.
- (3) Water Level 57 feet below top of ground.
- (4) Cased to 147, Size 2
- (5) Screen: Size Open, Length \_\_\_\_\_
- (6) Were any formations sealed against pollution?  
\_\_\_\_\_ yes, \_\_\_\_\_ no.

If YES depth of formation \_\_\_\_\_


Why \_\_\_\_\_

Drillers Remarks: Shale Trap

327.147 FT.

3' x 5' concrete slab

around well

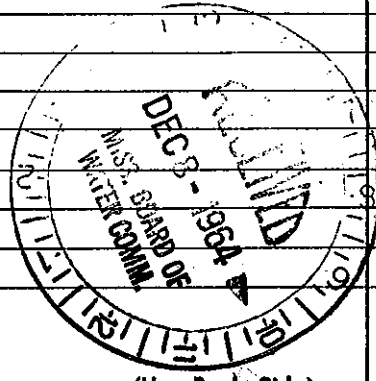

(Use Back Side)

Well No.

Mail this copy to Board of Water Commissioners 429 Miss. St. Jackson, Mis.