

CHOCTAW MISSISSIPPI BOARD OF WATER COMMISSIONERS


F14

WATER WELL DRILLERS LOG

2-30-66

Date: 2-30, 1966 Driller: Smith, Fergal ~~Wald~~ county Choctaw
 (Name) Choctaw

	Description & Color of Materials Sand, Clay, Red Clay, Shell, etc.	Thick- ness Feet	Depth Feet
(1) Owner of Land: <u>Joe Varns</u> (Name) <u>R.I. near miss</u> (Address)	<u>Yellow clay</u>	<u>15</u>	<u>15</u>
(2) Location: <u>E 2 1/4, NE 1/4, Sec. 30 T17R7</u> <u>2 miles north of French</u> (distance) (direction) (Nearest Town)	<u>Gray clay</u> <u>Black clay</u> <u>with a coal bit</u>	<u>17</u>	<u>32</u>
(3) Topography: <u>Hilly</u> (Hilly) (Flat) (Level)	<u>mixture</u> <u>blue clay</u>	<u>7</u>	<u>39</u>
(4) Purpose of Well: <u>Domestic</u> (Domestic Irrigation Municipal, Industrial, Other)	<u>black clay</u> <u>sand and</u>	<u>26</u>	<u>65</u>
Information upon completion of well:	<u>Clay mixture</u> <u>gray sand</u>	<u>21</u>	<u>106</u>
(1) Diameter <u>2</u> inches.	<u>tan clay</u> <u>mixture</u>	<u>41</u>	<u>147</u>
(2) Total Depth <u>162</u> feet.	<u>gray sand</u> <u>a very good</u> <u>grade</u>	<u>15</u>	<u>162</u>
(3) Water Level <u>50</u> feet below top of ground.			
(4) Cased to <u>156</u> , Size <u>2</u>			
(5) Screen: Size <u>1/4</u> , Length <u>6'</u>			
(6) Were any formations sealed against pollution? <u>yes, X</u> no.			
If YES depth of formation _____			
Why _____			
Drillers Remarks: _____			

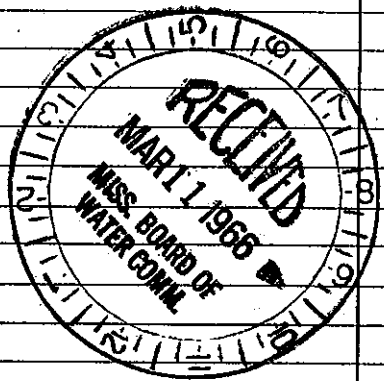

(Use Back Side)

3

Well No.

Mail this copy to Board of Water Commissioners 429 Miss. St. Jackson, Miss.