

CHOCTAW MISSISSIPPI BOARD OF WATER COMMISSIONERS

F15
2-3-64

WATER WELL DRILLERS LOG

CODED


Date: 2-3, 1964, Driller: MERRITT DRILLING CO. County CHOCTAW
(Name)

(1) Owner of Land: MRS. WELDON CATLEDGE
(Name)
ACKERMAN, MISS
(Address)
36178
(2) Location: 1/4, 1/4, Sec. T R
1 1/2 miles south, of ACKERMAN
(distance) (direction) (Nearest Town)
(3) Topography: ✓
(Hilly) (Flat) (Level)
(4) Purpose of Well: DOMESTIC
(Domestic Irrigation, Municipal, Industrial, Other)

Description & Color of Materials Sand, Clay, Red Clay, Shell, etc.	Thick- ness Feet	Depth Feet
Red CLAY	0	14
Red SAND	14	45
Blue CLAY	45	55
MIXED Blue SAND & CLAY	125	126
Blue CLAY - SOFT	126	168
HARD Blue SAND & CLAY	168	189
Blue CLAY	189	201
Hard rock -	201	202
Blue CLAY	202	218
GREEN CLAY - HARD	218	231
SOFT Blue CLAY	231	240
HARD Blue CLAY	240	268
FINE Blue SAND	268	315

Information upon completion of well:

(1) Diameter 2 inches.
(2) Total Depth 315 feet.
(3) Water Level 105 feet below top of ground.
(4) Cased to 147, Size 2
(5) Screen: Size open, Length _____
(6) Were any formations sealed against pollution?
✓ yes, _____ no.
If YES depth of formation 147'
Why Shale TRAP
Drillers Remarks: _____

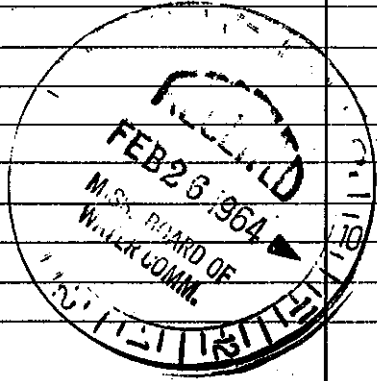

(Use Back Side)

Well No.

Mail this copy to Board of Water Commissioners 429 Miss. St. Jackson, Miss.