

CHOCTAW

MISSISSIPPI BOARD OF WATER COMMISSIONERS

~~803~~ G 7

WATER WELL DRILLERS LOG

11-22-64

Date: NOV. 22, 1964, Driller: J. L. Herritt, County: Choctaw

(Name)

(1) Owner of Land: G. W. Miller
(Name)
Ackerman, Miss.
(Address)
(2) Location: 32 17 10
9 miles West of Ackem
(distance) (direction) (Nearest Town)
(3) Topography: Hilly
(Hilly) (Flat) (Level)
(4) Purpose of Well: Domestic
(Domestic Irrigation
Municipal, Industrial, Other)

Description & Color of Materials Sand, Clay, Red Clay, Shell, etc.	Thick- ness Feet	Depth Feet
Red Sand	0	22
Blue Clay + Rock	22	60
Light Clay	60	65
Lignite	65	66
Blue Clay	66	68
Lignite	68	74
Green Clay	74	90
Lignite	90	100
Light Blue Clay	100	110
Lignite	110	112
Blue Clay + Shell	112	132
Light Blue Sand	132	138
Blue Clay	138	140
Rock	140-141	
Blue Clay + Lignite	141	147
Lignite	147	150
Blue Clay	150	157
Rock	157	159
Blue Sand	159	164
Rock	164	167
Blue Sand	167	184
Blue Sand	184	231


Information upon completion of well:

(1) Diameter 7 inches.
(2) Total Depth 231 feet.
(3) Water Level 126 feet below top of ground.
(4) Cased to 147, Size 2"
(5) Screen: Size Open, Length _____
(6) Were any formations sealed against pollution?
_____ yes, no.

If YES depth of formation _____

Why _____

Drillers Remarks: _____

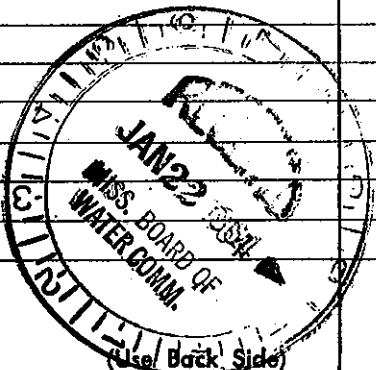

Well No. _____

Mail this copy to Board of Water Commissioners 429 Miss. St. Jackson, Miss.