

CHOCTAW MISSISSIPPI BOARD OF WATER COMMISSIONERS

G 10

5-2-61

WATER WELL DRILLERS LOG

CODED

Date: 5/2/61, 19___, Driller: L.K. Merritt County Choctaw

(Name)

(1) Owner of Land: <u>John Bowie</u> (Name)	Description & Color of Materials Sand, Clay, Red Clay, Shell, etc.	Thick- ness Feet	Depth Feet
<u>Ackerman, Miss.</u> (Address)	<u>Dark brown clay + soft</u>	0	6
(2) Location: <u>3/4</u> , <u>31 17 10</u> Sec. T R	<u>Fine sand.</u>	6	21
<u>6</u> miles <u>NW</u> of <u>ACKERMAN</u> (distance) (direction) (Nearest Town)	<u>Med Coarse sand.</u>	21	26
(3) Topography: <input checked="" type="checkbox"/> (Hilly) <input type="checkbox"/> (Flat) <input type="checkbox"/> (Level)	<u>Coarse sand</u>	26	36
(4) Purpose of Well: <u>DOMESTIC</u> (Domestic Irrigation, Municipal, Industrial, Other)			


Information upon completion of well:

- (1) Diameter 2 inches.
- (2) Total Depth 36 feet.
- (3) Water Level 22 feet below top of ground.
- (4) Cased to 28, Size 2
- (5) Screen: Size 1/4, Length 6
- (6) Were any formations sealed against pollution?
 yes, no.

If YES depth of formation _____

Why _____

Drillers Remarks: _____

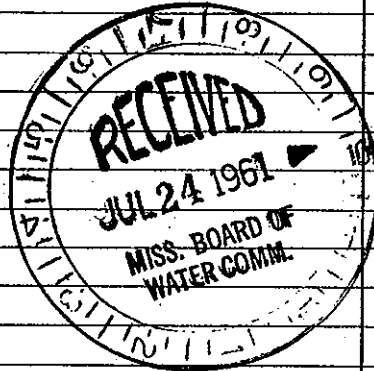

Well No.

(Use Back Side)

Mail this copy to Board of Water Commissioners 429 Miss. St. Jackson, Miss.