

CHOCTAW

MISSISSIPPI BOARD OF WATER COMMISSIONERS

G-14

2-16-63

WATER WELL DRILLERS LOG

CODED

Date: Feb 16, 1963, Driller: J. M. Merritt County Choctaw

(Name)

(1) Owner of Land: <u>Everette Childs</u> (Name) <u>Weir, Miss.</u> (Address) <th data-bbox="665 495 1088 556">Description &amp; Color of Materials Sand, Clay, Red Clay, Shell, etc.</th> <th data-bbox="1088 495 1161 556">Thick- ness Feet</th> <th data-bbox="1161 495 1234 556">Depth Feet</th>	Description & Color of Materials Sand, Clay, Red Clay, Shell, etc.	Thick- ness Feet	Depth Feet
(2) Location: <u>33 1710</u> T. R. <u>33 1710</u> miles of <u>Weir</u> (distance) (direction) (Nearest Town)	Red CLAY	0	15
	LIGNITE	15	50
	CLAY & SAND.	20	55
	Rock 6"		
	FINE TAN SAND.	55	82
	COARSE SAND.	82	180
(3) Topography: _____ (Hilly) (Flat) (Level)			
(4) Purpose of Well: _____ (Domestic Irrigation Municipal, Industrial, Other)			


Information upon completion of well:

- (1) Diameter 2' inches.
- (2) Total Depth 115' feet.
- (3) Water Level \_\_\_\_\_ feet below top of ground.
- (4) Cased to 106', Size 2"
- (5) Screen: Size 1 1/2", Length 6 ft.
- (6) Were any formations sealed against pollution?  
\_\_\_\_\_ yes,  no.

If YES depth of formation \_\_\_\_\_

Why \_\_\_\_\_

Drillers Remarks: \_\_\_\_\_

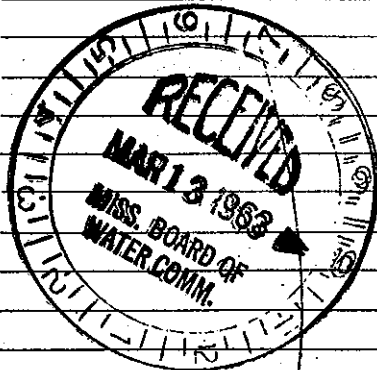

(Use Back Side)

Well No.

Mail this copy to Board of Water Commissioners 429 Miss. St. Jackson, Miss