

CHOCTAW

MISSISSIPPI BOARD OF WATER COMMISSIONERS

G 15

10-21-62

WATER WELL DRILLERS LOG

CODED

Date: 10-21, 1962

Driller: O. L. MERRITT

County: Choctaw

(Name)

(1) Owner of Land: <u>ELWIN KING</u> (Name)	Description & Color of Materials Sand, Clay, Red Clay, Shell, etc.	Thick- ness Feet	Depth Feet
<u>Wick Miss</u> (Address)	<u>Red SAND + CLAY</u>	<u>0</u>	<u>35</u>
(2) Location: <u>32 17 10</u> T R	<u>White SAND</u>	<u>35</u>	<u>60</u>
<u>4</u> miles <u>NORTH</u> of <u>Wick</u> (distance) (direction) (Nearest Town)			
(3) Topography: <u>Hilly</u> (Hilly) (Flat) (Level)			
(4) Purpose of Well: <u>DOMESTIC</u> (Domestic Irrigation Municipal, Industrial, Other)			


Information upon completion of well:

- (1) Diameter 2 inches.
- (2) Total Depth 60 feet.
- (3) Water Level 25 feet below top of ground.
- (4) Cased to 50, Size 2
- (5) Screen: Size 1/4, Length 6'
- (6) Were any formations sealed against pollution?
 yes, no.

If YES depth of formation _____

Why _____

Drillers Remarks: _____

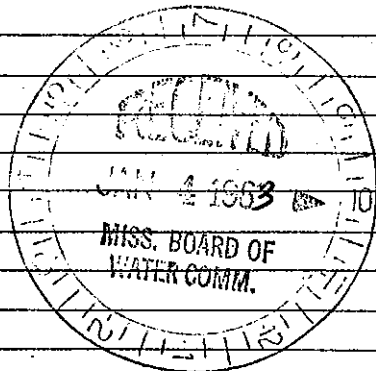

Well No.

(Use Back Side)

Mail this copy to Board of Water Commissioners 429 Miss. St. Jackson, Miss.