

~~MISSISSIPPI~~  
CHOCTAW  
6-11-63

MISSISSIPPI BOARD OF WATER COMMISSIONERS

G 17

WATER WELL DRILLERS LOG CODED

Date: 6-11, 1963, Driller: MERRITT DRILLING Co County WINSTON  
(Name)

(1) Owner of Land:	Description & Color of Materials Sand, Clay, Red Clay, Shell, etc.	Thick- ness Feet	Depth Feet
<u>MELVIN SMITH</u> (Name)	<u>Red CLAY</u>	<u>0</u>	<u>12</u>
<u>WEIR MISS</u> (Address)	<u>Red CLAY &amp; SAND</u>	<u>0</u>	<u>36</u>
(2) Location: <u>32 17 10</u> 1/4, 1/4, Sec. T R	<u>LANITAN</u>	<u>36</u>	<u>38</u>
<u>2</u> miles <u>NORTH</u> of <u>WEIR</u> (distance) (direction) (Nearest Town)	<u>TAN SAND</u>	<u>38</u>	<u>63</u>
(3) Topography: <u>Hilly</u> (Hilly) (Flat) (Level)	<u>White SAND</u>	<u>63</u>	<u>85</u>
(4) Purpose of Well: <u>DOMESTIC</u> (Domestic Irrigation Municipal, Industrial, Other)			


Information upon completion of well:

- (1) Diameter 2 inches.
- (2) Total Depth 85 feet.
- (3) Water Level 63 feet below top of ground.
- (4) Cased to 79, Size 2
- (5) Screen: Size 1 1/4, Length 6'
- (6) Were any formations sealed against pollution?  
no

If YES depth of formation \_\_\_\_\_

Why \_\_\_\_\_

Drillers Remarks: \_\_\_\_\_

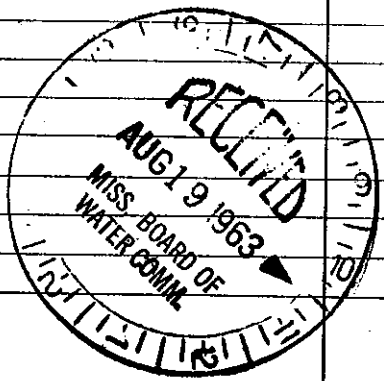

(Use Back Side)

Well No.

Retain this copy for your office files.