

**CHOCTAW MISSISSIPPI BOARD OF WATER COMMISSIONERS**

**G 22**

**CODED**

**WATER WELL DRILLERS LOG**

Date: 6-26-64, 1964, Driller: MLK RIT DRILLING County CHOCTAW  
 (Name)

(1) Owner of Land: <u>A. D. JINKINS</u> (Name)	Description & Color of Materials Sand, Clay, Red Clay, Shell, etc.	Thick- ness Feet	Depth Feet
<u>RT. 3. ACKERMAN</u> (Address)	<u>Red clay</u>	<u>0</u>	<u>12</u>
(2) Location: <u>10 17 10</u> <u>6</u> miles <u>West</u> of <u>ACKERMAN</u> (distance) (direction) (Nearest Town)	<u>Red sand.</u>	<u>12</u>	<u>28</u>
(3) Topography: <u>Hilly</u> (Hilly) (Flat) (Level)	<u>Rock.</u>	<u>28</u>	<u>29</u>
(4) Purpose of Well: <u>Domestic</u> (Domestic Irrigation Municipal, Industrial, Other)	<u>Yellow clay</u>	<u>29</u>	<u>45</u>
	<u>White sand.</u>	<u>45</u>	<u>50</u>
	<u>Blue clay</u>	<u>50</u>	<u>59</u>
	<u>Rock.</u>	<u>59</u>	<u>60</u>
	<u>Blue clay / Light</u>	<u>60</u>	<u>78</u>
	<u>Green clay.</u>	<u>78</u>	<u>90</u>
	<u>Blue clay</u>	<u>80</u>	<u>93</u>
	<u>Blue sand.</u>	<u>93</u>	<u>155</u>


Information upon completion of well:

- (1) Diameter 2 inches.
- (2) Total Depth 155 feet.
- (3) Water Level 60' feet below top of ground.
- (4) Cased to 92, Size 2"
- (5) Screen: Size Open; Length \_\_\_\_\_
- (6) Were any formations sealed against pollution?  
 yes,  no.

If YES depth of formation \_\_\_\_\_

Why \_\_\_\_\_

Drillers Remarks: \_\_\_\_\_

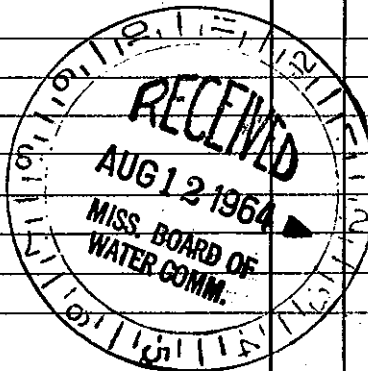

Well No. \_\_\_\_\_

(Use Back Side)

Mail this copy to Board of Water Commissioners 429 Miss. St. Jackson, Miss: