

CHOCTAW MISSISSIPPI BOARD OF WATER COMMISSIONERS

G 24

WATER WELL DRILLERS LOG

9-10-64

Date: 9-10, 1964, Driller: MERRITT DRILLING CO. County: CHOCTAW
(Name)

CODED

(1) Owner of Land:	Description & Color of Materials Sand, Clay, Red Clay, Shell, etc.	Thick- ness Feet	Depth Feet
<u>G.H. Crowder</u> <small>(Name)</small>	<u>Red clay</u>	<u>6</u>	<u>15</u>
<u>RT. 3. Ackenman</u> <small>(Address)</small>	<u>TAN + white sand</u>	<u>15</u>	<u>75</u>
<u>171710</u> <small>(Address)</small>	<u>Rock</u>	<u>75</u>	<u>76</u>
(2) Location: <u>1/4</u> , <u>171710</u> Sec. <u>T. R.</u>			
<u>4</u> miles <u>North</u> , of <u>Weir</u> <small>(distance) (direction) (Nearest Town)</small>			
(3) Topography: <u>Hilly</u> <small>(Hilly) (Flat) (Level)</small>			
(4) Purpose of Well: <u>Domestic</u> <small>(Domestic Irrigation Municipal, Industrial, Other)</small>			


Information upon completion of well:

- (1) Diameter 2 inches.
- (2) Total Depth 76 feet.
- (3) Water Level 32 feet below top of ground.
- (4) Cased to 70, Size 2
- (5) Screen: Size 2, Length 6'
- (6) Were any formations sealed against pollution?
 yes, no.

If YES depth of formation _____

Why _____

Drillers Remarks: _____

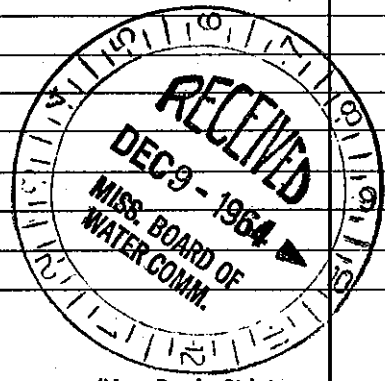

(Use Back Side)

Well No.

Mail this copy to Board of Water Commissioners 429 Miss. St. Jackson, Mis: