

CHOCTAW MISSISSIPPI BOARD OF WATER COMMISSIONERS

WATER WELL DRILLERS LOG

CODED

Date: 10-21-63, 1963, Driller: MERRITT DRILLING CO County Choctaw
Culloch (Name)

(1) Owner of Land: J. H. Mc Caffee
 (Name)
Tom Nolen, Miss
 (Address)
35 1710
 (2) Location: 1/4 Sec. 24, T. 1 R. 10
5 miles South, of Tom Nolen
 (distance) (direction) (Nearest Town)
 (3) Topography: Hilly
 (Hilly) (Flat) (Level)
 (4) Purpose of Well: Domestic
 (Domestic Irrigation Municipal, Industrial, Other)


Description & Color of Materials Sand, Clay, Red Clay, Shell, etc.	Thick- ness Feet	Depth Feet
White + Blue SAND	0	28
LIGNITE	28	35
Trace of SAND + Blue CLAY	35	75
LIGNITE	75	80
Green CLAY	80	105
LIGNITE	105	107
HARD Blue CLAY	107	130
LIGNITE	130	138
HARD Green CLAY	138	150
Blue CLAY ^{cased}	150	164
SOFT CLAY ^{cased}	164	169
Blue CLAY + LIGNITE	169	189
Blue CLAY Trace of SAND	189	210
Fine Blue SAND	210	250

Information upon completion of well:

(1) Diameter 2 inches.
 (2) Total Depth 250 feet.
 (3) Water Level 30 feet below top of ground.
 (4) Cased to 168, Size 2
 (5) Screen: Size open, Length _____
 (6) Were any formations sealed against pollution?
 _____ yes, _____ no.

If YES depth of formation Shale trap
at 168'
 Why _____

Drillers Remarks: _____

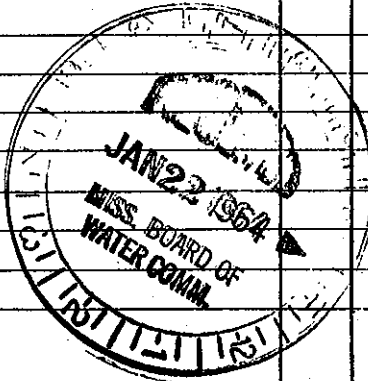

(Use Back Side)

Well No. _____

Mail this copy to Board of Water Commissioners 429 Miss. St. Jackson, Miss.