

CHOCTAW MISSISSIPPI BOARD OF WATER COMMISSIONERS

G 26

WATER WELL DRILLERS LOG

5-14-65

CODED

Date: 5-14, 1965, Driller: MERRY DRILLING County CHOCTAW  
(Name)

(1) Owner of Land	Description & Color of Materials Sand, Clay, Red Clay, Shell, etc.	Thick- ness Feet	Depth Feet
<u>JOHN R. FUNDRIE</u> (Name)	<u>Red clay</u>	<u>0</u>	<u>10</u>
<u>RT. 3. ACKERMAN</u> (Address)	<u>Yellow</u>	<u>10</u>	<u>18</u>
(2) Location: <u>1/4 26 1/4, Sec. 17 10</u> T R	<u>Yellow clay + sand</u>	<u>18</u>	<u>36</u>
<u>2</u> miles <u>West</u> , of <u>ACKERMAN</u> (distance) (direction) (Nearest Town)	<u>Mix'd clay + sand</u>	<u>36</u>	<u>45</u>
(3) Topography: <u>Hilly</u> (Hilly) (Flat) (Level)	<u>White SAND</u>	<u>45</u>	<u>94</u>
(4) Purpose of Well: <u>Domestic</u> (Domestic Irrigation Municipal, Industrial, Other)			


Information upon completion of well:

- (1) Diameter 2 inches.
- (2) Total Depth 94 feet.
- (3) Water Level 45 feet below top of ground.
- (4) Cased to 84, Size 2
- (5) Screen: Size 1 1/4, Length 6'
- (6) Were any formations sealed against pollution?  
\_\_\_\_\_ yes,  no.

If YES depth of formation \_\_\_\_\_

Why \_\_\_\_\_

Drillers Remarks: \_\_\_\_\_

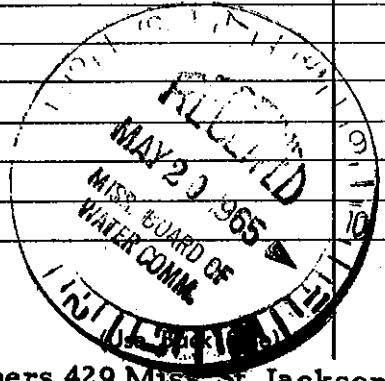

Well No. \_\_\_\_\_

Mail this copy to Board of Water Commissioners 429 Miss. St. Jackson, Mis: