

CHOCTAW MISSISSIPPI BOARD OF WATER COMMISSIONERS

G 21

WATER WELL DRILLERS LOG


CODED

5-24-65

Date: 5-24, 1965, Driller: Merritt Drilling Co. Choctaw

(Name)

(1) Owner of Land:	Description & Color of Materials Sand, Clay, Red Clay, Shell, etc.	Thick- ness Feet	Depth Feet
DEAR WORREI (Name)	TOP SOIL	0	2
RT. 1 ACKERMAN, MISS (Address)	Red clay + sand	2	10
35 17 10 (2) Location: 1/4, 1/4, Sec. T. R.	White clay + sand	10	14
3 miles West of Ackerman (distance) (direction) (Nearest Town)	White sand	14	17
(3) Topography: Hilly (Hilly) (Flat) (Level)	Yellow clay + sand	17	20
(4) Purpose of Well: DOMESTIC - (Domestic Irrigation Municipal, Industrial, Other)	Blue Gumbo	20	45
Information upon completion of well:	Green clay	45	49
(1) Diameter 2 inches.	Blue clay	49	63
(2) Total Depth 250 feet.	Green clay	63	65
(3) Water Level 80 feet below top of ground.	Blue clay	65	66
(4) Cased to 126, Size 2	Thin Rock		
(5) Screen: Size 5/8", Length	Blue clay + sand	66	75
(6) Were any formations sealed against pollution?	Blue clay	75	80
yes, no.	Soft Blue clay	80	91
If YES depth of formation 5' 1/2" trap	Lignite	91	92
Why At 126 ft.	Blue clay	92	95
Drillers Remarks:	Green clay	95	100
	Blue clay	100	106
	Lignite	106	108
	Blue clay	108	110
	Lignite	110	113
	Soft Blue clay	113	123
	Green clay	123	180
	3" Rock		
	Blue clay	180	192
	Fine Blue sand	192	198
	Blue clay	198	206
	Blue clay	206	209
	Lignite	209	211
	Blue clay	211	215
	Lignite	215	216
	Blue clay	216	250

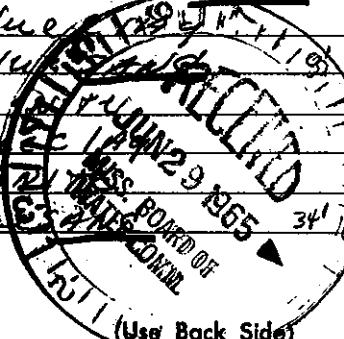

Well No.

Mail this copy to Board of Water Commissioners 429 Miss. St. Jackson, Mis: