

CHOCTAW MISSISSIPPI BOARD OF WATER COMMISSIONERS

G 28

WATER WELL DRILLERS LOG

CODED

Date: 6-15-65, 1965, Driller: ~~Robert D. ...~~ County Choctaw

MARATH DRILLING CO.

(1) Owner of Land: Bobby Pruitt
(Name)

RT #3 - Ackerman, Miss
(Address)

(2) Location: 33 17 10
1/4, 1/4, Sec. T R

4 miles WEST of Ackerman
(distance) (direction) (Nearest Town)

(3) Topography: Hilly
(Hilly) (Flat) (Level)

(4) Purpose of Well: DOMESTIC
(Domestic Irrigation Municipal, Industrial, Other)

Description & Color of Materials Sand, Clay, Red Clay, Shell, etc.	Thick- ness Feet	Depth Feet
Red clay	0	9
White clay + sand	9	14
yellow sand	14	21
4" HARD ROCK		
SOFT BLUE CLAY	21	48
3" HARD ROCK		
SOFT BLUE CLAY	48	54
THIN ROCK		
Blue clay	54	64
Blue clay + sand	64	73
Blue sand	73	110
Blue sand + clay	110	165
LIGNITE	165	166
Blue clay	166	168

Information upon completion of well:

(1) Diameter 2 inches.

(2) Total Depth 168 feet.

(3) Water Level 40 feet below top of ground.

(4) Cased to 65, Size 2"


(5) Screen: Size OPEN END, Length _____

(6) Were any formations sealed against pollution?
 _____ yes, _____ no.

SMALL TRAY AT 63'
 If YES depth of formation.

Why _____

Drillers Remarks: _____

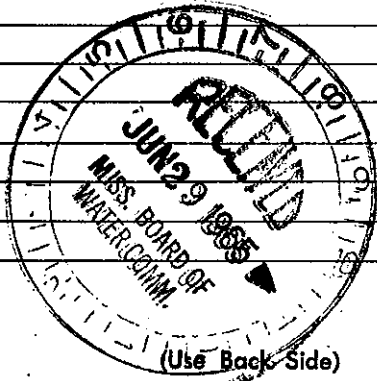

Well No. _____

Mail this copy to Board of Water Commissioners 429 Miss. St. Jackson, Miss.