

CHOCTAW MISSISSIPPI BOARD OF WATER COMMISSIONERS

G 31

WATER WELL DRILLERS LOG

10-13-65

Date: 10-13, 1965, Driller: MERRITT DRILLING CO. ^{CODED} Choctaw
 (Name)

(1) Owner of Land:	Description & Color of Materials Sand, Clay, Red Clay, Shell, etc.	Thick- ness Feet	Depth Feet
<u>HENRY BATES</u> (Name) <u>RT. 1 - Ackerman, Miss.</u> (Address)	<u>Red Clay</u>	<u>2</u>	<u>8</u>
(2) Location: <u>1/4</u> , <u>26 17 10</u> Sec. <u>T</u> <u>R</u>	<u>Yellow clay</u>	<u>5</u>	<u>23</u>
<u>2</u> miles <u>WEST</u> , of <u>Ackerman</u> (distance) (direction) (Nearest Town)	<u>Blue clay</u>	<u>23</u>	<u>74</u>
(3) Topography: <u>Hilly</u> (Hilly) (Flat) (Level)	<u>Blue sand</u>	<u>74</u>	<u>120</u>
(4) Purpose of Well: <u>Domestic</u> (Domestic Irrigation Municipal, Industrial, Other)			

Information upon completion of well:

(1) Diameter 2 inches.

(2) Total Depth 120 feet.

(3) Water Level 50 feet below top of ground.

(4) Cased to 112, Size 24


(5) Screen: Size 1/4, Length 6'

(6) Were any formations sealed against pollution?
 _____ yes, no.

If YES depth of formation _____

Why _____

Drillers Remarks: _____

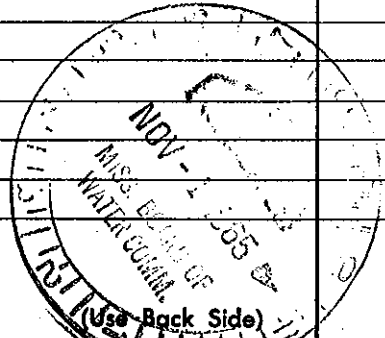

Well No. _____

Mail this copy to Board of Water Commissioners 429 N. 1st St. Jackson, Miss.