

CHOCTAW MISSISSIPPI BOARD OF WATER COMMISSIONERS

G³²

11-4-65

WATER WELL DRILLERS LOG

Date: 11-4, 1965, Driller: Merritt Drillings, county Choctaw
(Name)

CODED

(1) Owner of Land: Grady Bagwell
(Name)
RT #3 - Akeman
(Address)
11 1710
 (2) Location: 1/4, 1/4, Sec. T R
6 miles N.W., of Akeman
(distance) (direction) (Nearest Town)
 (3) Topography: Hilly
(Hilly) (Flat) (Level)
 (4) Purpose of Well: DOMESTIC
(Domestic Irrigation Municipal, Industrial, Other)


Description & Color of Materials Sand, Clay, Red Clay, Shell, etc.	Thick- ness Feet	Depth Feet
Red Clay	0	6
Buff clay	6	17
Blue clay	17	20
Blue sand	20	21
Blue clay	21	34
Light	34	36
Blue clay	36	40
Light	40	41
Blue clay	41	54
2" Rock		
Blue sand	54	58
Blue Gumbo	58	61
Light	61	63
Blue clay	63	65
Green clay	65	67
Green sand	67	87
Blue clay	87	93
Light	93	105
Blue clay	105	112
Green clay + sand	112	114
Blue Gumbo	114	125
Soft Gumbo sand	125	127
Light + blue clay	127	150
Green clay	150	168
Hard clay + sand	168	189
Light + clay	189	202
Thin Rock		
Blue clay	202	210
Blue sand	210	233

Cased

Information upon completion of well:

(1) Diameter 2 inches.
 (2) Total Depth 233 feet.
 (3) Water Level 60' feet below top of ground.
 (4) Cased to 147, Size 2
 (5) Screen: Size open, Length _____
 (6) Were any formations sealed against pollution?
 _____ yes, _____ no.

If YES depth of formation _____
 Why _____
 Drillers Remarks: Shale trap
set at end of
casing.

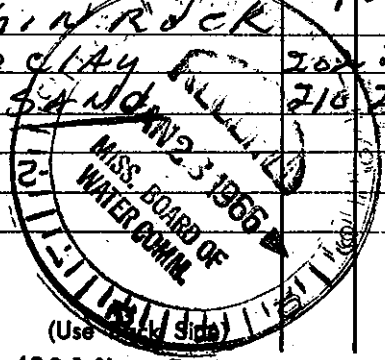

Well No.

Mail this copy to Board of Water Commissioners 429 Miss. St. Jackson, Mis.