

MISSISSIPPI BOARD OF WATER COMMISSIONERS

G 34

3-4-66

WATER WELL DRILLERS LOG

CODED

Date: 3-4, 1966, Driller: MERRITT DRILLING Co County Choctaw
(Name)

(1) Owner of Land: <u>Mrs LORNA WOOD</u> (Name)	Description & Color of Materials Sand, Clay, Red Clay, Shell, etc.	Thick- ness Feet	Depth Feet
RT. # <u>2</u> <u>ACKERMAN</u> , Miss (Address)	<u>Red clay</u>	<u>0</u>	<u>10</u>
(2) Location: <u>1/4</u> , <u>21 17 10</u> Sec. <u>T</u> <u>R</u>	<u>Blue clay</u>	<u>10</u>	<u>23</u>
<u>5</u> miles <u>N.W.</u> , of <u>ACKERMAN</u> (distance) (direction) (Nearest Town)	<u>Grey sand</u>	<u>23</u>	<u>34</u>
(3) Topography: <u>Hilly</u> (Hilly) (Flat) (Level)			
(4) Purpose of Well: <u>DOMESTIC</u> (Domestic Irrigation Municipal, Industrial, Other)			

Information upon completion of well:

(1) Diameter 2 inches.

(2) Total Depth 34 feet.

(3) Water Level 20 feet below top of ground.

(4) Cased to 24, Size 2


(5) Screen: Size 1 1/4, Length 6'

(6) Were any formations sealed against pollution?
 yes, no.

If YES depth of formation _____

Why _____

Drillers Remarks: _____

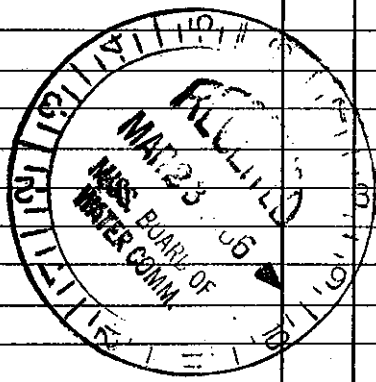

Well No.

(Use Back Side)

Mail this copy to Board of Water Commissioners 429 Miss. St. Jackson, Miss