

Choctaw

MISSISSIPPI BOARD OF WATER COMMISSIONERS

Carroll
4/24/68

10-66
G 36

WATER WELL DRILLERS LOG

CODED OR

Date: 10-24, 1966, Driller: J. H. Hare County Choctaw

(Name)

(1) Owner of Land:	Description & Color of Materials Sand, Clay, Red Clay, Shell, etc.	Thick- ness Feet	Depth Feet
Michael Ervins (Name)	Red clay	4	4
Ackerman Miss (Address)	clay + sand	5	9
(2) Location: NE 1/4, NE 1/4, Sec. 34 T17R10	pink + white clay	6	15
4 1/2 miles west, of Ackerman (distance) (direction) (Nearest Town)	blue clay	25	40
(3) Topography: Flat (Hilly) (Flat) (Level)	blue clay + sand	24	64
(4) Purpose of Well: Home (Domestic Irrigation Municipal, Industrial, Other)	Blue Sand	64	105


Information upon completion of well:

- (1) Diameter 2 inches.
- (2) Total Depth 105 feet.
- (3) Water Level 15 feet below top of ground.
- (4) Cased to 63', Size 2"
- (5) Screen: Size open, Length _____
- (6) Were any formations sealed against pollution?
_____ yes, no.

If YES depth of formation _____

Why _____

Drillers Remarks: _____

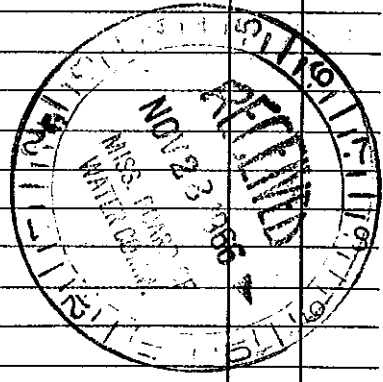

Well No. _____

(Use Back Side)

Mail this copy to Board of Water Commissioners 429 Miss. St. Jackson, Miss.