

CHOCTAW MISSISSIPPI BOARD OF WATER COMMISSIONERS

H 4

WATER WELL DRILLERS LOG

CODE 300

11-5-60

Date: 11/25/1960, Driller: L.K. Merritt County Choctaw

(Name)


(1) Owner of Land: L. L. Biddle
 (Name)
Ockerman Mass
 (Address)
 (2) Location: 1/4, 13, 17N1E
 Sec. T R
4 miles W of Sturgis
 (distance) (direction) (Nearest Town)
 (3) Topography: (Hilly) (Flat) (Level)
 (4) Purpose of Well: Domestic
 (Domestic Irrigation
 Municipal, Industrial, Other)

Description & Color of Materials Sand, Clay, Red Clay, Shell, etc.	Thick- ness Feet	Depth Feet
Light Grey sand clay	0	7
Tan sand	7	11
Grey sand, mica clay & silt	11	15
Blue clay + fine sand	15	20
2" Rock at 20'		
Blue soapstone	20	24
Fine blue sand, clay + mica	24	27
Soft soapstone	27	35
blue clay, trace of fine sand	35	41
sand + blue clay	41	46
Coarse grey sand	46	78
Fine grey sand	78	83

Information upon completion of well:

(1) Diameter 2 inches.
 (2) Total Depth 83 feet.
 (3) Water Level 25 feet below top of ground.
 (4) Cased to 71, Size _____
 (5) Screen: Size 1 1/4", Length 10'
 (6) Were any formations sealed against pollution?
 _____ yes, no.

Did not drill to bottom of fine grey sand

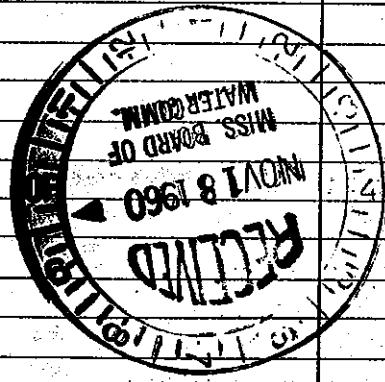

If YES depth of formation _____
 Why _____
 Drillers Remarks: _____

Well No.

(Use Back Side)

Mail this copy to Board of Water Commissioners 429 Miss. St. Jackson, Miss.