

CHOCTAW

MISSISSIPPI BOARD OF WATER COMMISSIONERS

H 5

CONF

8-31-61

WATER WELL DRILLERS LOG

H 301

Date: 8/31/61, 19___, Driller: L. K. Merritt County Choctaw
(Name)

		Description & Color of Materials Sand, Clay, Red Clay, Shell, etc.	Thick- ness Feet	Depth Feet
(1) Owner of Land: <u>L. B. Ballard</u> (Name)		Surgeon Clay	0	4
<u>Ackerman Miss.</u> (Address)		4" Rock at 4"		
(2) Location: <u>1/4</u> , <u>1/4</u> , Sec. <u>17 11</u> , T. <u>1</u> , R. <u>1</u>		Red Surgeon sand	4	20
<u>1/2</u> miles <u>SE</u> , of <u>Ackerman</u> (distance) (direction) (Nearest Town)		Coarse water sand	20	30
(3) Topography: <input checked="" type="checkbox"/> (Hilly) <input type="checkbox"/> (Flat) <input type="checkbox"/> (Level)		Coarse sand, gravel	30	36
(4) Purpose of Well: <u>Domestic</u> (Domestic Irrigation Municipal, Industrial, Other)		Sand rock		
		Buff clay at 36		


Information upon completion of well:

- (1) Diameter 2 inches.
- (2) Total Depth 36 feet.
- (3) Water Level 20 feet below top of ground.
- (4) Cased to 29, Size 2
- (5) Screen: Size 1/4, Length 6'
- (6) Were any formations sealed against pollution?
no.

If YES depth of formation _____

Why _____

Drillers Remarks: _____

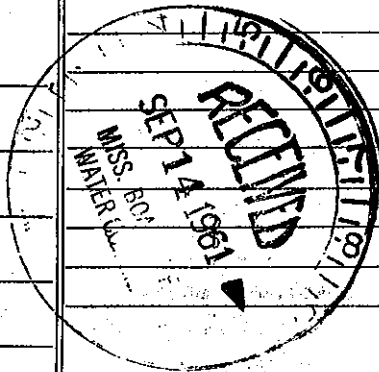

(Use Back Side)

Well No.

Mail this copy to Board of Water Commissioners 429 Miss. St. Jackson, Miss