

CHOCTAW
H7

MISSISSIPPI BOARD OF WATER COMMISSIONERS
CODE 14

10-23-62

WATER WELL DRILLERS LOG

Date: 10-23, 1962, Driller: J. L. MERRITT County: Choctaw
(Name)

(1) Owner of Land:	Description & Color of Materials Sand, Clay, Red Clay, Shell, etc.	Thick- ness Feet	Depth Feet
(Name) LINDSEY ALVARADO	Red CLAY	0	13
(Address) ACKERMAN, MISS	Red SAND.	15	35
32 1711	Blue CLAY	35	150
(2) Location: 1/4, 1/4, Sec. T. R.	LIGNITE	150	152
2 miles South of Ackerman	Rock	153	153
(distance) (direction) (Nearest Town)	Blue CLAY	153	210
(3) Topography: Hilly	LIGNITE		
(Hilly) (Flat) (Level)	Rock	210	212
(4) Purpose of Well: Domestic	LIGNITE	212	220
(Domestic Irrigation Municipal, Industrial, Other)	Blue CLAY	220	315
	Blue SAND.	315	335


Information upon completion of well:

- (1) Diameter 2 inches.
- (2) Total Depth 347 feet.
- (3) Water Level 130 feet below top of ground.
- (4) Cased to 273, Size open
- (5) Screen: Size _____, Length _____.
- (6) Were any formations sealed against pollution?
yes, no.

If YES depth of formation SHALE

Why Trap STAT. 270

Drillers Remarks:

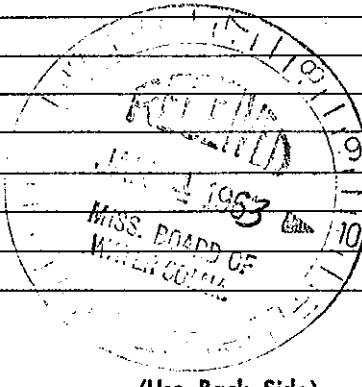

(Use Back Side)

Well No.

Mail this copy to Board of Water Commissioners 429 Miss. St. Jackson, Miss.