

CHOCTAW

H 8

5-63

MISSISSIPPI BOARD OF WATER COMMISSIONERS

WATER WELL DRILLERS LOG CODED

Date: MAY, 1963, Driller: J. L. MURPHY County CHOCTAW

(Name)

| (1) Owner of Land: <u>JAMES STACY</u><br>(Name)   | Description & Color of Materials<br>Sand, Clay, Red Clay, Shell, etc. | Thick-<br>ness<br>Feet | Depth<br>Feet |
|---|---|------------------------|---------------|
| <u>ACKERMAN</u><br>(Address)  | Red CLAY  | 0                      | 21            |
| (2) Location: <u>7 17 11</u><br><u>1/4</u> , <u>1/4</u> , Sec. <u>17 11</u> T <u>17</u> R <u>11</u> | Yellow SAND   | 21                     | 25            |
| _____ miles _____ of _____<br>(distance) (direction) (Nearest Town)                                 | <del>Green CLAY</del>   |                        |               |
| (3) Topography: <u>Hilly</u><br>(Hilly) (Flat) (Level)  | LIGNITE   | 25                     | 30            |
| (4) Purpose of Well: <u>Domestic</u><br>(Domestic Irrigation<br>Municipal, Industrial, Other)       | GREEN CLAY  | 30                     | 50            |
|   | LIGNITE   | 50                     | 52            |
|   | GRAY CLAY   | 52                     | 65            |
|   | Blue Gumbo  | 65                     | 90            |
|   | Blue Shale  | 90                     | 92            |
|   | Blue Gumbo  | 92                     | 105           |
|   | Blue Shale  | 105                    | 168           |
|   | Blue Shale SAND   | 168                    | 189           |


Information upon completion of well:

- (1) Diameter 2 inches.
- (2) Total Depth 189 feet.
- (3) Water Level 30 feet below top of ground.
- (4) Cased to 126, Size 2
- (5) Screen: Size OPEN, Length \_\_\_\_\_
- (6) Were any formations sealed against pollution?  
\_\_\_\_\_ yes, \_\_\_\_\_ no.

If YES depth of formation \_\_\_\_\_

Why SHAL TRAP AT 126

Drillers Remarks: \_\_\_\_\_

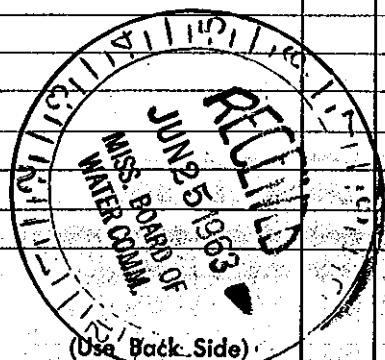

Well No. \_\_\_\_\_

Mail this copy to Board of Water Commissioners 429 Miss. St. Jackson, Miss