

CHOCTAW

MISSISSIPPI BOARD OF WATER COMMISSIONERS

H 9

7-10-63

WATER WELL DRILLERS LOG CODED

Date: 7-10, 1963, Driller: MERRITT DRILLING CO. County CHOCTAW
(Name)

(1) Owner of Land:	Description & Color of Materials Sand, Clay, Red Clay, Shell, etc.	Thick- ness Feet	Depth Feet
<u>Shelly McManis</u> (Name)	<u>Red CLAY</u>	<u>0</u>	<u>25</u>
<u>ACKERMAN, MISS</u> (Address)	<u>LIGNITE</u>		
<u>7 17 11</u>	<u>VERY FINE Blue SAND</u>	<u>25</u>	<u>30</u>
(2) Location: <u>1/4</u> , <u>1/4</u> , Sec. <u>T</u> <u>R</u>	<u>Blue CLAY</u>	<u>30</u>	<u>60</u>
<u>2</u> miles <u>NORTH</u> of <u>Ackerman</u>	<u>CLAY & LIGNITE</u>	<u>60</u>	<u>95</u>
(distance) (direction) (Nearest Town)	<u>Trace of Blue</u>		
(3) Topography: <u>Hilly</u>	<u>SAND</u>	<u>95</u>	<u>116</u>
(Hilly) (Flat) (Level)	<u>Very FINE Blue SAND</u>	<u>116</u>	<u>128</u>
(4) Purpose of Well: <u>DOMESTIC</u>			
(Domestic Irrigation Municipal, Industrial, Other)			

Information upon completion of well:

(1) Diameter 2 inches.

(2) Total Depth 128 feet.

(3) Water Level 63' feet below top of ground.

(4) Cased to 84, Size 2"


(5) Screen: Size open, Length _____

(6) Were any formations sealed against pollution?
✓ yes, _____ no.

If YES depth of formation Shell Trap

Why Set 84 ft.

Drillers Remarks: _____

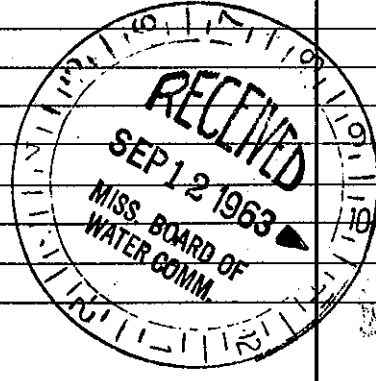

(Use Back Side)

Well No.

Mail this copy to Board of Water Commissioners 429 Miss. St. Jackson, Miss!